


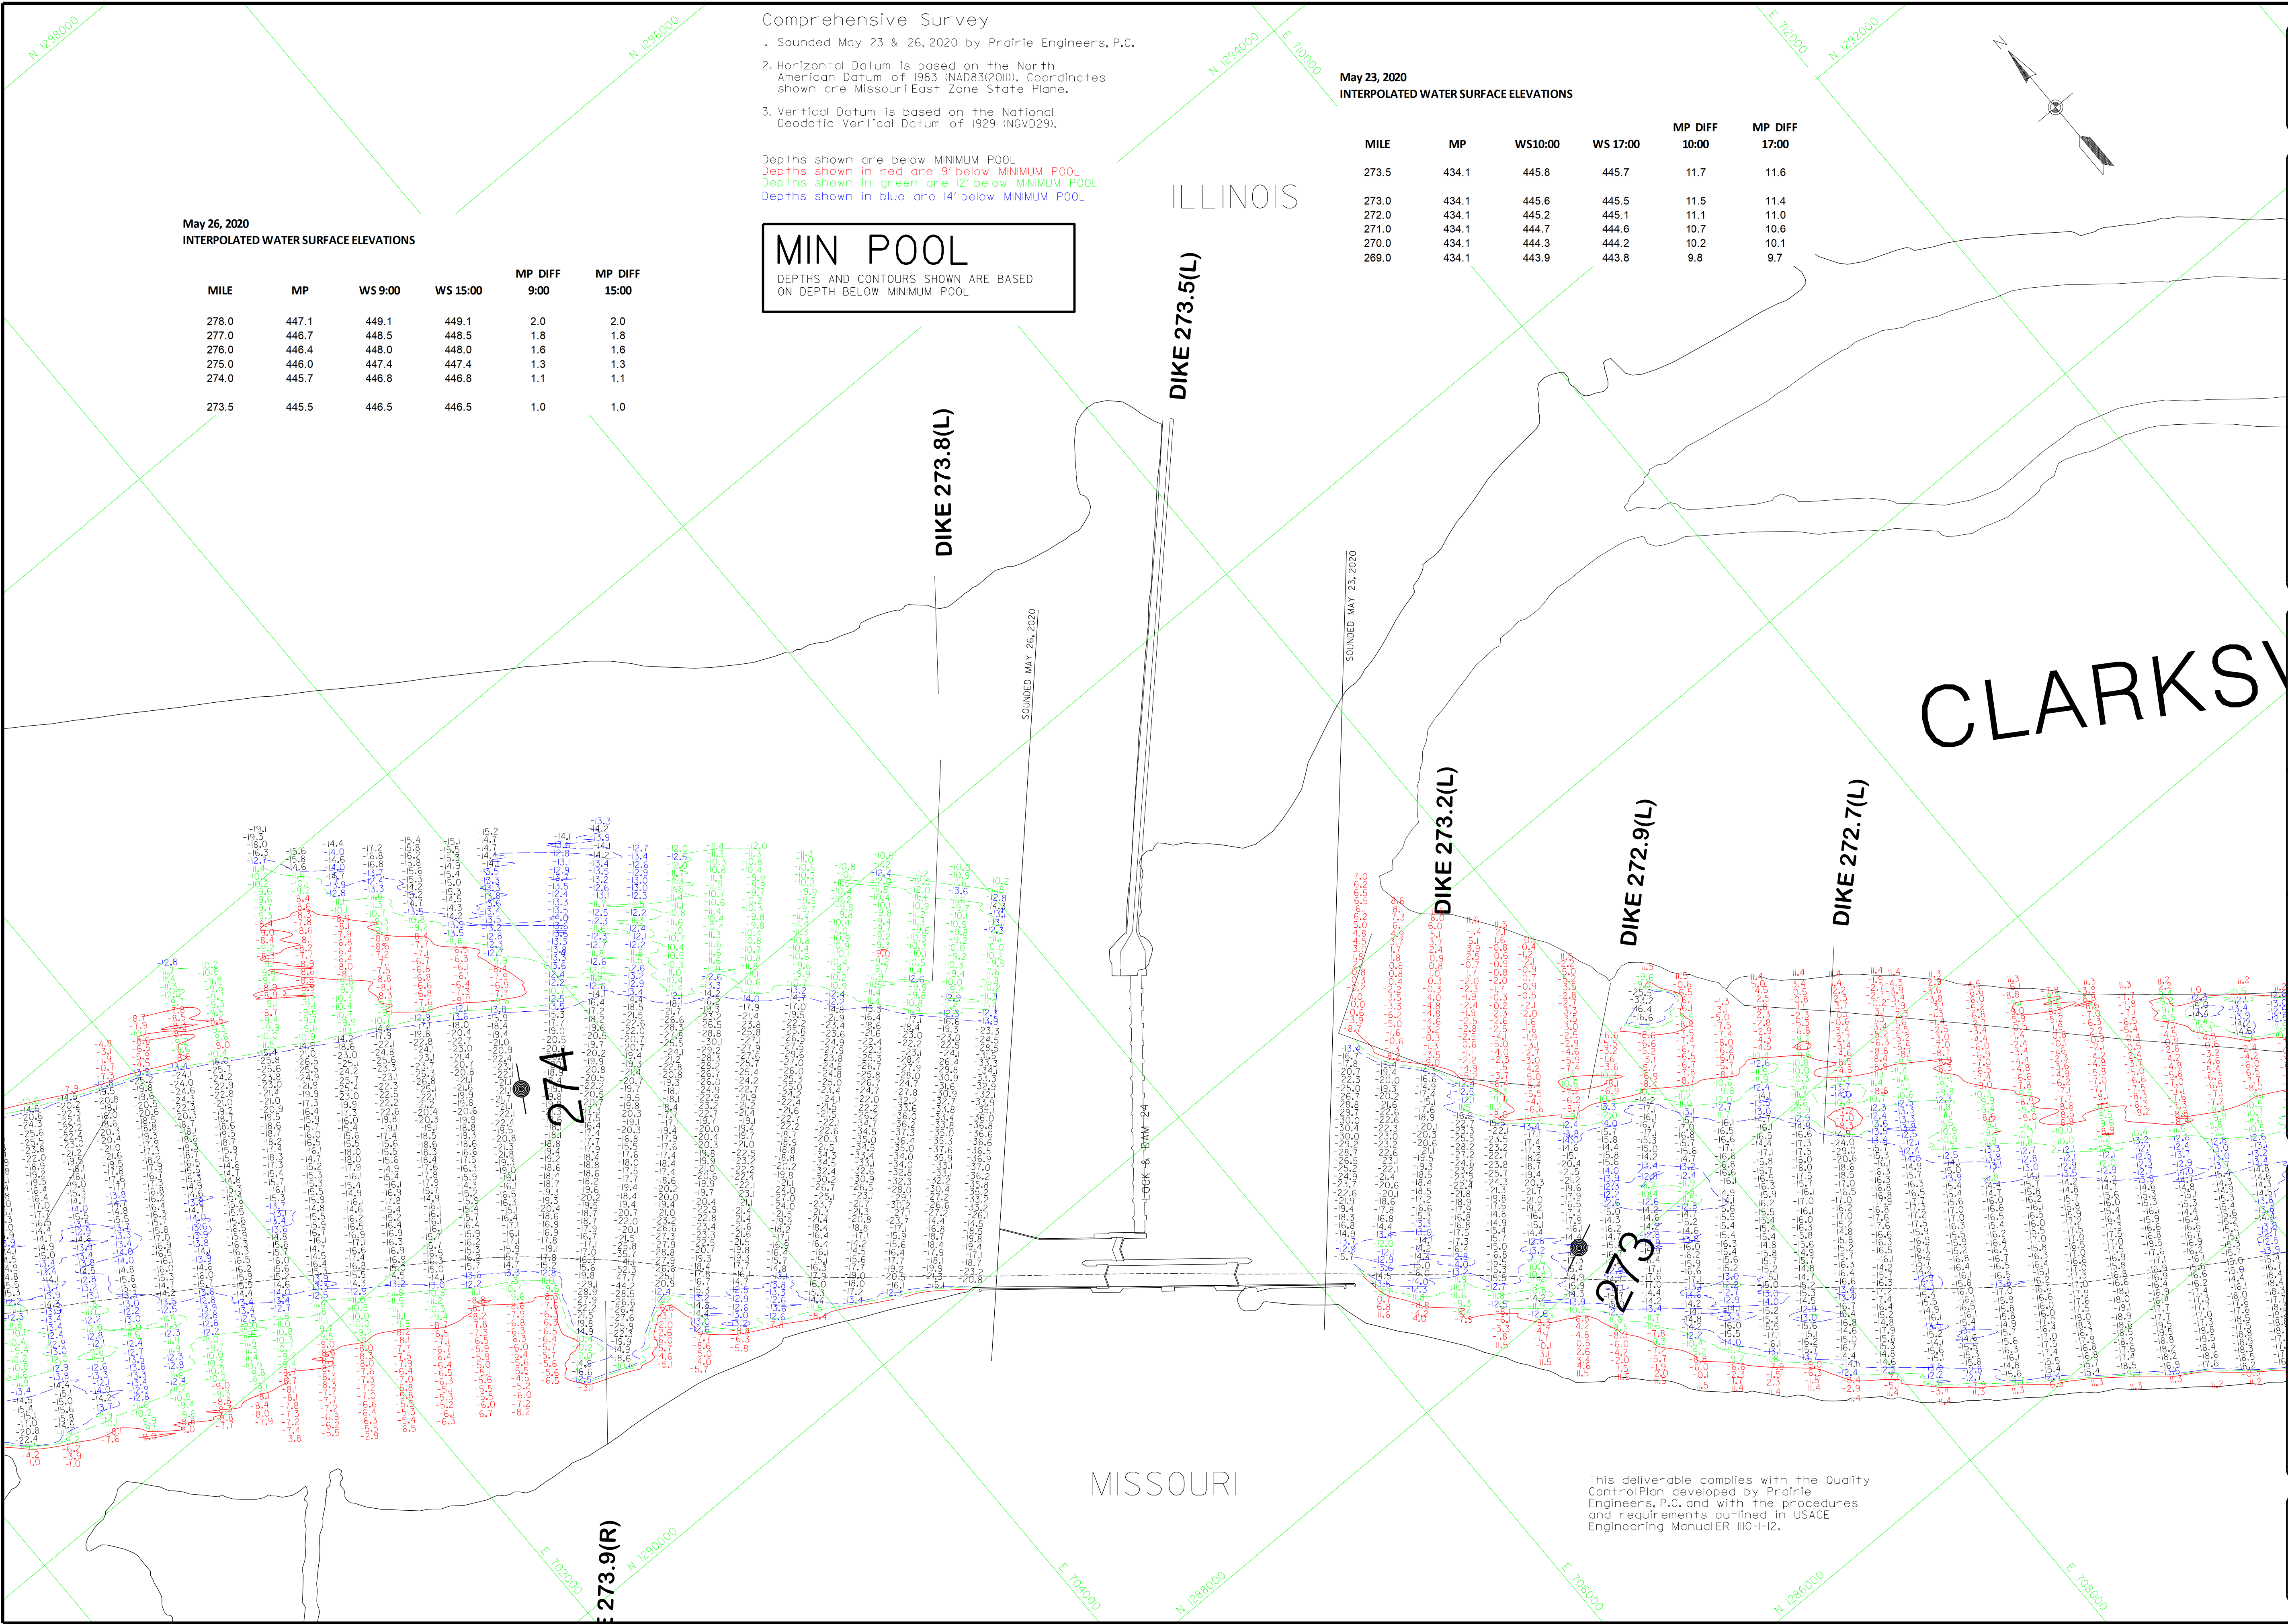

Comprehensive Survey

- 1. Sounded May 23 & 26, 2020 by Prairie Engineers, P.C.
- 2. Horizontal Datum is based on the North American Datum of 1983 (NAD83(2011)). Coordinates shown are Missouri East Zone State Plane.
- 3. Vertical Datum is based on the National Geodetic Vertical Datum of 1929 (NGVD29).

Depths shown are below MINIMUM POOL
Depths shown in red are 9' below MINIMUM POOL
Depths shown in green are 12' below MINIMUM POOL
Depths shown in blue are 14' below MINIMUM POOL

MIN POOL

DEPTHS AND CONTOURS SHOWN ARE BASED ON DEPTH BELOW MINIMUM POOL

May 26, 2020
INTERPOLATED WATER SURFACE ELEVATIONS

MILE	MP	WS 9:00	WS 15:00	MP DIFF 9:00	MP DIFF 15:00
278.0	447.1	449.1	449.1	2.0	2.0
277.0	446.7	448.5	448.5	1.8	1.8
276.0	446.4	448.0	448.0	1.6	1.6
275.0	446.0	447.4	447.4	1.3	1.3
274.0	445.7	446.8	446.8	1.1	1.1
273.5	445.5	446.5	446.5	1.0	1.0

May 23, 2020
INTERPOLATED WATER SURFACE ELEVATIONS

MILE	MP	WS 10:00	WS 17:00	MP DIFF 10:00	MP DIFF 17:00
273.5	434.1	445.8	445.7	11.7	11.6
273.0	434.1	445.6	445.5	11.5	11.4
272.0	434.1	445.2	445.1	11.1	11.0
271.0	434.1	444.7	444.6	10.7	10.6
270.0	434.1	444.3	444.2	10.2	10.1
269.0	434.1	443.9	443.8	9.8	9.7

US Army Corps of Engineers
St. Louis District

WATER SURFACE	ZERO NADVD, MILE	MIN POOL	CAGE RECORD	
			LOUISIANA	L&O 24 (U)
			437.3	428
			282.8	273.5
			448.8	445.5
			453.9 (09800)	446.5 (09800)
			452 (09800)	446.3 (09800)
			26 MAY 2020	

Survey Date: May 23, 2020

SUBMITTED: Chief, Engr. Data Mgt. Sect.

Chief, Engr. Data Mgt. Sect.

Plot date: 7/31/2020

Plot scale: 1"=400'

U.S. ARMY ENGINEER DIVISION
CORPS OF ENGINEERS
ST. LOUIS, MISSOURI

UPPER MISSISSIPPI RIVER BASIN
MISSISSIPPI RIVER


Scale: 300.0 - 195.0 MILE

COMPREHENSIVE SURVEY

PLATE NUMBER

14

This deliverable complies with the Quality Control Plan developed by Prairie Engineers, P.C. and with the procedures and requirements outlined in USACE Engineering Manual E-110-1-12.

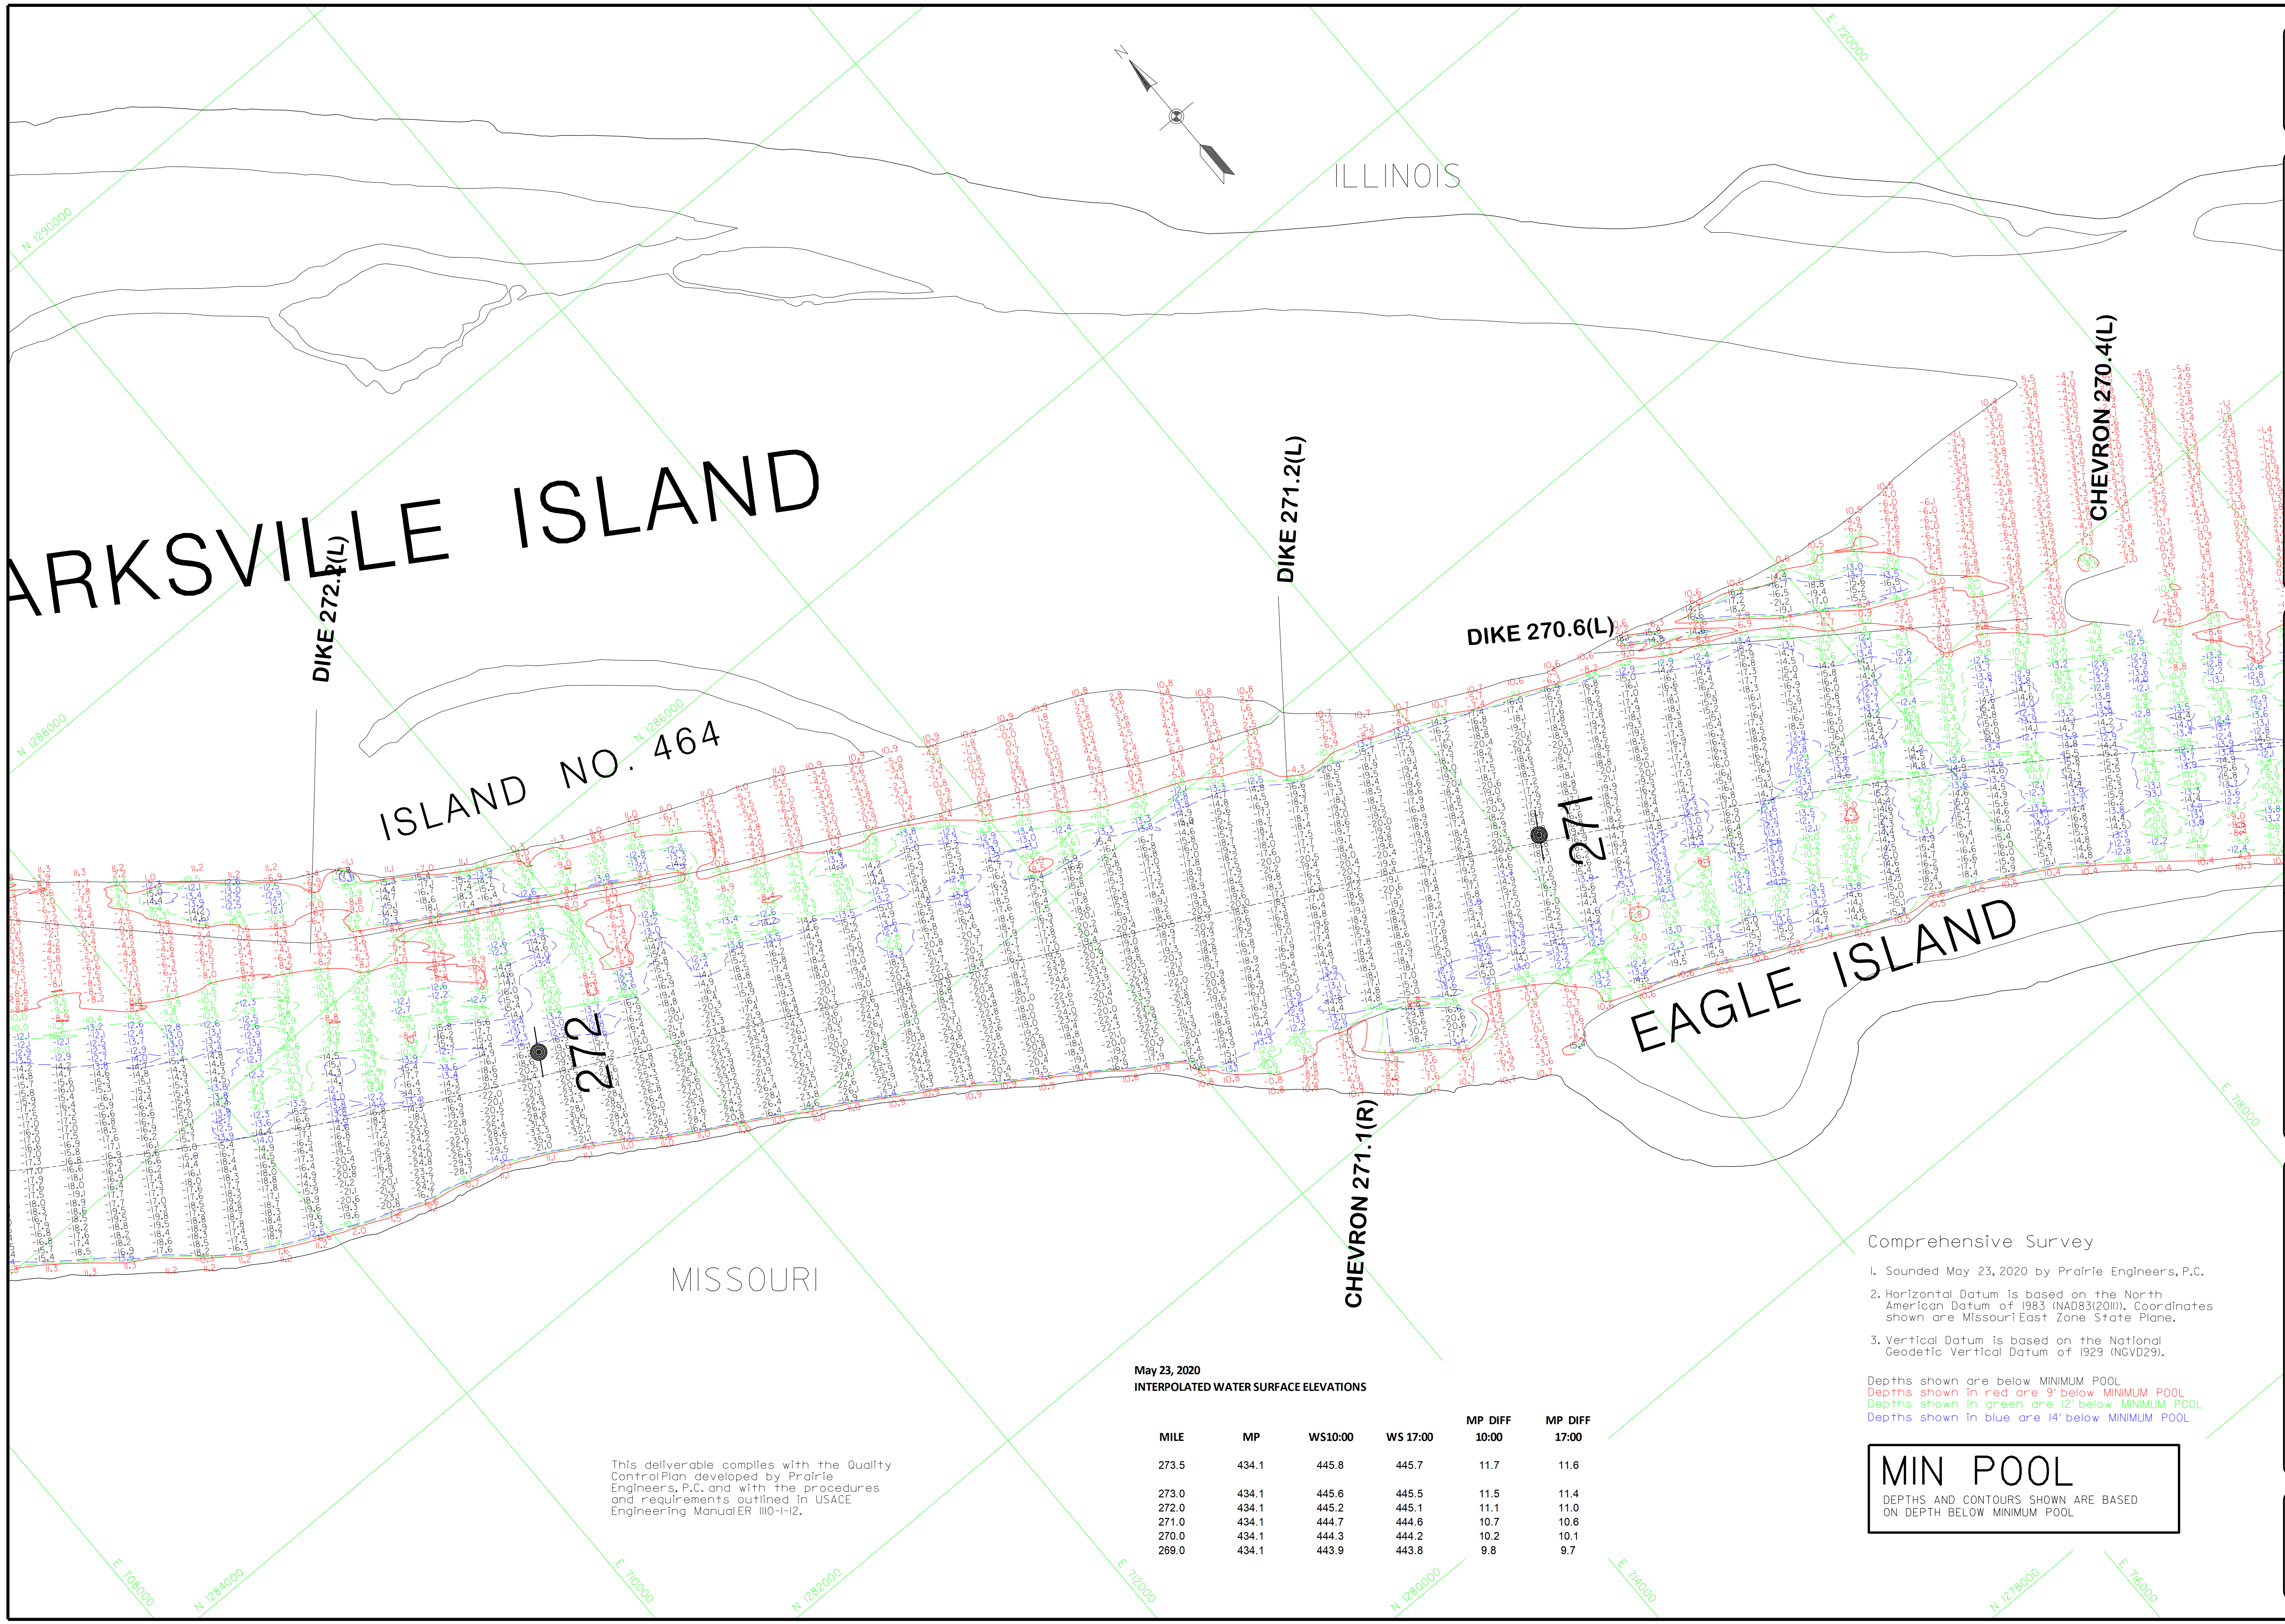

CASE RECORD		DATE	
WATER SURFACE	L & D 24 LU	DATE	TIME
ZERO NGVD	291.8	4/25/0	
MILE	273.5	26/0	
MIN POOL	434.0	434.0	
	23 MAY 2020	445.8 (1660)	442.0 (1630)
		445.7 (1650)	442.0 (1620)

Survey Date: May 23, 2020		SUBMITTED:	
Drawn by: DCC by: BJB	DEF	Chief, Engr. Data Mgt. Sect.	
Reviewed by:		File path: 273 24m.dgn	
APPROVED:		Plot date: 7/31/2020	
Chief, Geospatial Branch		Plot scale: 1"=400'	

240 METERS
0 120 240
400 800 FEET

THE INFORMATION DEPICTED ON THIS MAP REPRESENTS THE RESULTS OF A SURVEY CONDUCTED UNDER THE GENERAL CONDITIONS LISTED IN THE PRELIMINARY REPORT.

COMPREHENSIVE SURVEY
MILE: 300.0 - 195.0

PLATE
NUMBER
15

This deliverable complies with the Quality Control Plan developed by Prairie Engineers, P.C. and with the procedures and requirements outlined in USACE Engineering Manual ER 1110-I-12.

May 23, 2020
INTERPOLATED WATER SURFACE ELEVATIONS

MILE	MP	WS		MP DIFF	
		WS10:00	WS17:00	10:00	17:00
273.5	434.1	445.8	445.7	11.7	11.6
273.0	434.1	445.6	445.5	11.5	11.4
272.0	434.1	445.2	445.1	11.1	11.0
271.0	434.1	444.7	444.6	10.7	10.6
270.0	434.1	444.3	444.2	10.2	10.1
269.0	434.1	443.9	443.8	9.8	9.7


Comprehensive Survey

- Sounded May 23, 2020 by Prairie Engineers, P.C.
- Horizontal Datum is based on the North American Datum of 1983 (NAD83(2011)). Coordinates shown are Missouri East Zone State Plane.
- Vertical Datum is based on the National Geodetic Vertical Datum of 1929 (NGVD29).

Depths shown are below MINIMUM POOL
Depths shown in red are 9' below MINIMUM POOL
Depths shown in green are 12' below MINIMUM POOL
Depths shown in blue are 14' below MINIMUM POOL

MIN POOL

DEPTHS AND CONTOURS SHOWN ARE BASED ON DEPTH BELOW MINIMUM POOL

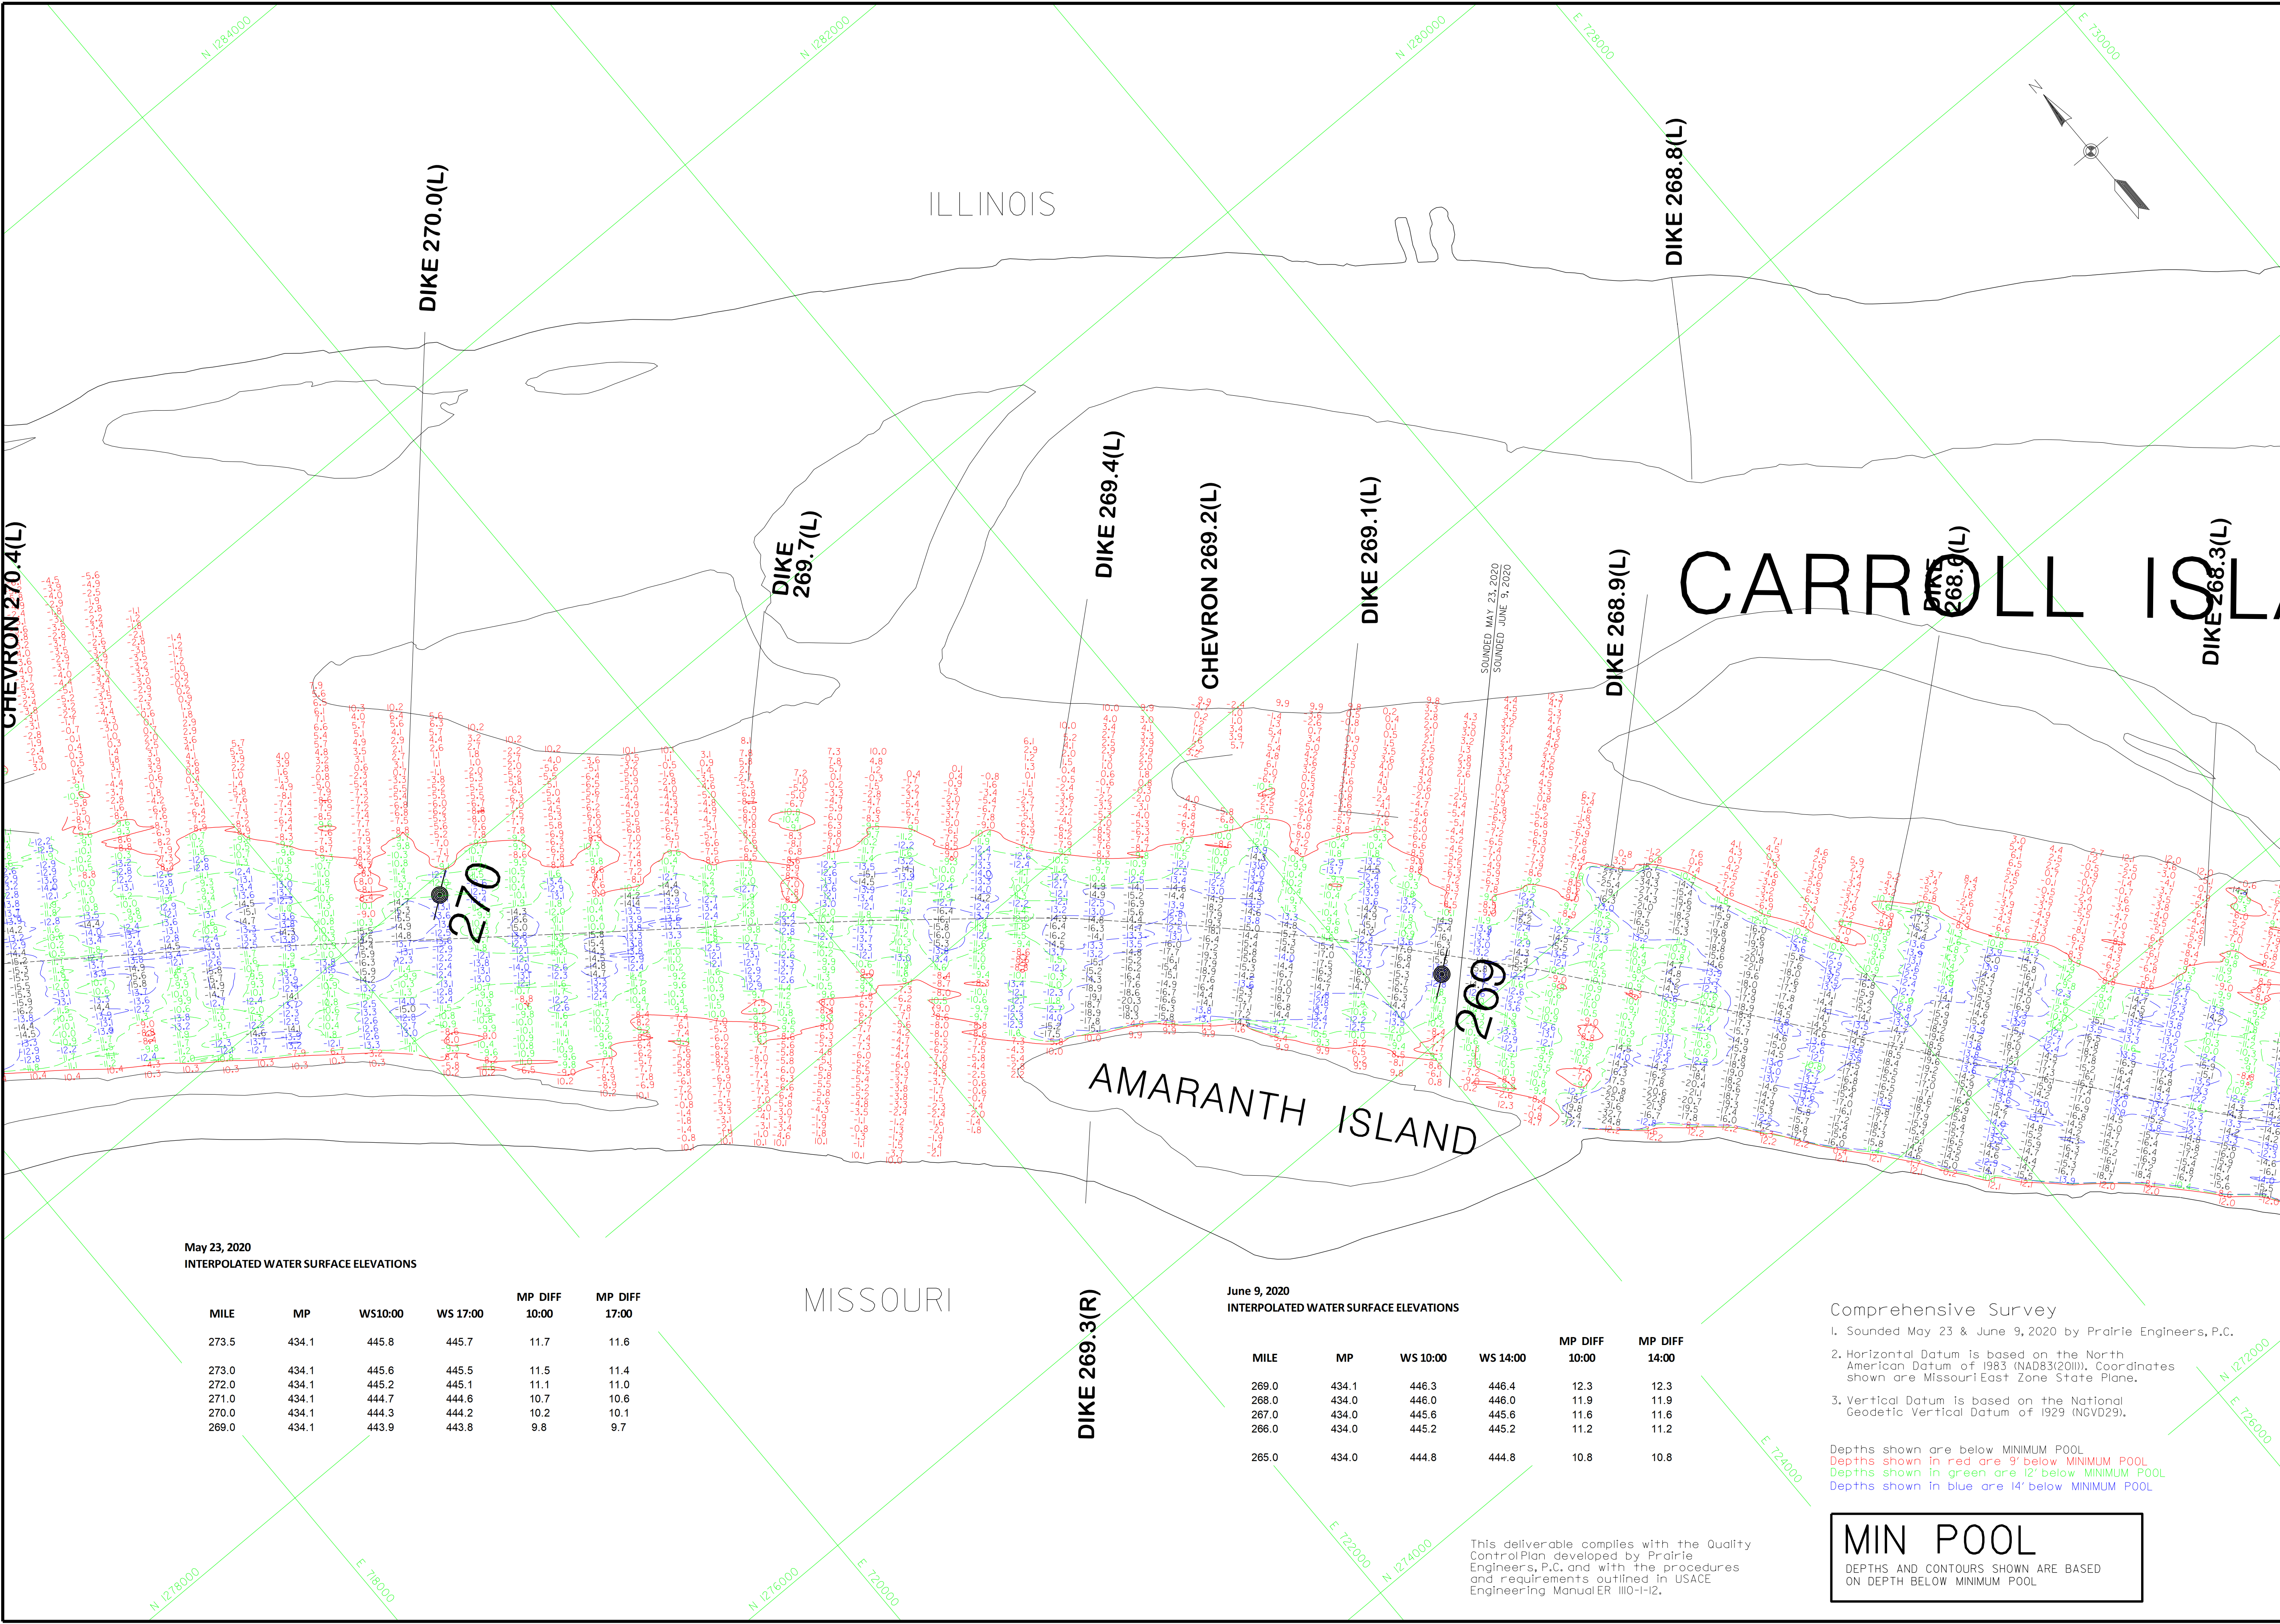

May 23, 2020
INTERPOLATED WATER SURFACE ELEVATIONS

MILE	MP	WS10:00	WS 17:00	MP DIFF 10:00	MP DIFF 17:00
273.5	434.1	445.8	445.7	11.7	11.6
273.0	434.1	445.6	445.5	11.5	11.4
272.0	434.1	445.2	445.1	11.1	11.0
271.0	434.1	444.7	444.6	10.7	10.6
270.0	434.1	444.3	444.2	10.2	10.1
269.0	434.1	443.9	443.8	9.8	9.7

June 9, 2020
INTERPOLATED WATER SURFACE ELEVATIONS

MILE	MP	WS 10:00	WS 14:00	MP DIFF 10:00	MP DIFF 14:00
269.0	434.1	446.3	446.4	12.3	12.3
268.0	434.0	446.0	446.0	11.9	11.9
267.0	434.0	445.6	445.6	11.6	11.6
266.0	434.0	445.2	445.2	11.2	11.2
265.0	434.0	444.8	444.8	10.8	10.8

Comprehensive Survey

- Sounded May 23 & June 9, 2020 by Prairie Engineers, P.C.
- Horizontal Datum is based on the North American Datum of 1983 (NAD83(2011)). Coordinates shown are Missouri East Zone State Plane.
- Vertical Datum is based on the National Geodetic Vertical Datum of 1929 (NGVD29).

Depths shown are below MINIMUM POOL
Depths shown in red are 9' below MINIMUM POOL
Depths shown in green are 12' below MINIMUM POOL
Depths shown in blue are 14' below MINIMUM POOL

MIN POOL

DEPTHS AND CONTOURS SHOWN ARE BASED ON DEPTH BELOW MINIMUM POOL

US Army Corps of Engineers
St. Louis District

WATER SURFACE		CASE RECORD	
L & D 24 LU	BPAP	L & D 24 LU	BPAP
ZERO NGVD	425.0	ZERO NGVD	425.0
MILE	273.5	MILE	265.0
MIN POOL	434.0	MIN POOL	434.0
23 MAY 2020		445.8 (560)	
		445.7 (560)	

Survey Dates: May 23, 2020
June 9, 2020

SUBMITTED:
Chief, Engr. Data Mgt. Sect.

File path: 273.24.mxd
Plot date: 7/31/2020
Plot scale: 1"=400'

U.S. ARMY ENGINEER DIVISION
CORPS OF ENGINEERS
ST. LOUIS, MISSOURI

UPPER MISSISSIPPI RIVER BASIN
MISSISSIPPI RIVER


240 METERS
800 FEET

THE INFORMATION DEPICTED ON THIS MAP REPRESENTS THE RESULTS OF A SURVEY CONDUCTED UNDER THE GENERAL CONDITIONS EXISTING AT THE TIME OF THE SURVEY.

COMPREHENSIVE SURVEY
MILE: 300.0 - 195.0

PLATE NUMBER

16

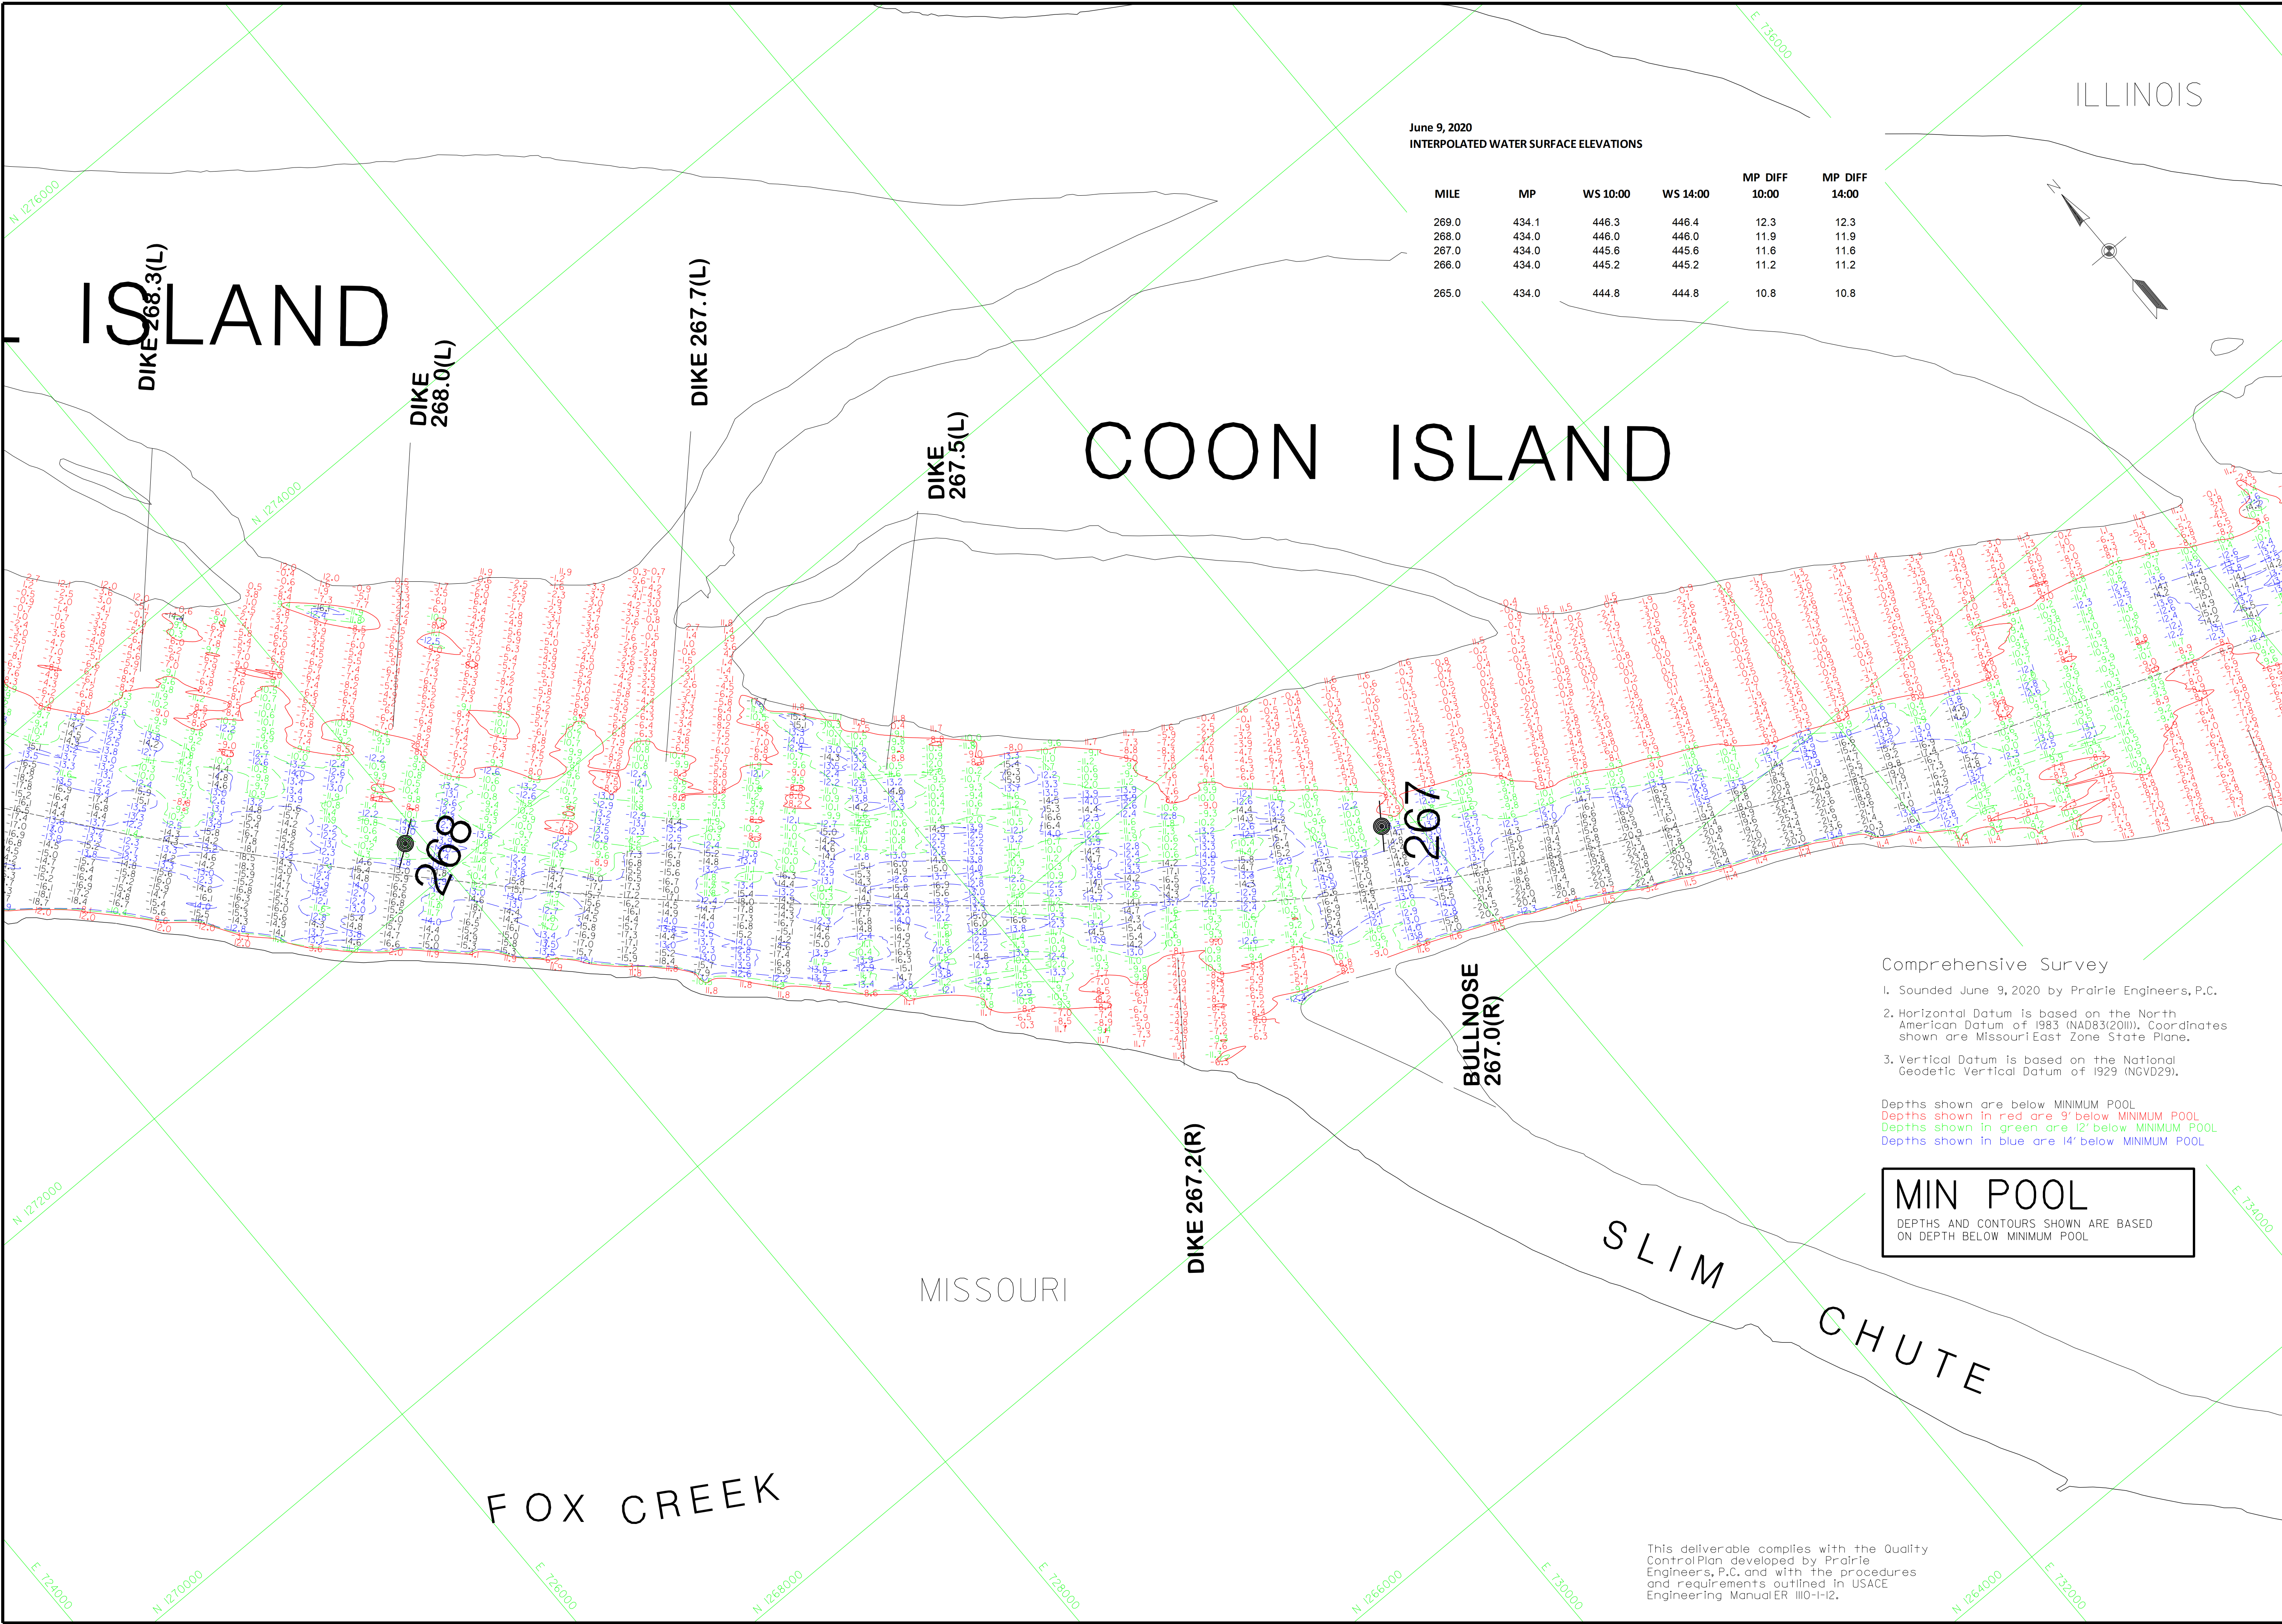

June 9, 2020
INTERPOLATED WATER SURFACE ELEVATIONS

MILE	MP	WS 10:00	WS 14:00	MP DIFF 10:00	MP DIFF 14:00
269.0	434.1	446.3	446.4	12.3	12.3
268.0	434.0	446.0	446.0	11.9	11.9
267.0	434.0	445.6	445.6	11.6	11.6
266.0	434.0	445.2	445.2	11.2	11.2
265.0	434.0	444.8	444.8	10.8	10.8

Comprehensive Survey

- Sounded June 9, 2020 by Prairie Engineers, P.C.
- Horizontal Datum is based on the North American Datum of 1983 (NAD83(2011)). Coordinates shown are Missouri East Zone State Plane.
- Vertical Datum is based on the National Geodetic Vertical Datum of 1929 (NGVD29).

Depths shown are below MINIMUM POOL
Depths shown in red are 9' below MINIMUM POOL
Depths shown in green are 12' below MINIMUM POOL
Depths shown in blue are 14' below MINIMUM POOL

MIN POOL

DEPTHS AND CONTOURS SHOWN ARE BASED ON DEPTH BELOW MINIMUM POOL

This deliverable complies with the Quality Control Plan developed by Prairie Engineers, P.C. and with the procedures and requirements outlined in USACE Engineering Manual ER 1110-I-12.



US Army Corps
of Engineers
St. Louis District

WATER SURFACE	L & D 24 (L)	BRPAP
ZERO NGVD	29.8	425.0
MILE	273.5	265.0
MIN POOL	434.0	434.0
09 JUN 2020	448.10(600)	444.8 10(600)
	448.10(600)	444.8 10(600)

Survey Date: June 9, 2020	SUBMITTED:
Drawn by: DCC by: BUB	Chief, Engr. Data Mgt. Sect.
Reviewed by:	File path: 273.24.mxd
APPROVED:	Plot date: 7/31/2020
Chief, Geospatial Branch	Plot scale: 1"=400'

U.S. ARMY ENGINEER DIVISION CORPS OF ENGINEERS ST. LOUIS, MISSOURI	UPPER MISSISSIPPI RIVER BASIN MISSISSIPPI RIVER
COMPREHENSIVE SURVEY MILE: 300.0 - 195.0	

PLATE NUMBER
17

This deliverable complies with the Quality Control Plan developed by Prairie Engineers, P.C. and with the procedures and requirements outlined in USACE Engineering Manual ER 1110-1-12.

June 10, 2020
INTERPOLATED WATER SURFACE ELEVATIONS

MILE	MP	WS 900	WS 1700	MP DIFF 900	MP DIFF 1700
265.0	434.0	445.2	445.2	11.2	11.2
264.0	434.0	444.9	444.9	10.9	10.9
263.0	434.0	444.5	444.5	10.5	10.5
262.0	434.0	444.1	444.2	10.1	10.2
261.0	434.0	443.8	443.8	9.8	9.8
260.3	434.0	443.5	443.6	9.5	9.6
260.0	433.9	443.4	443.5	9.4	9.5
259.0	433.7	442.9	443.0	9.2	9.3
258.0	433.5	442.5	442.6	9.0	9.1
242.0	429.8	435.2	435.3	5.4	5.5
241.5	429.7	435.0	435.1	5.3	5.4

June 9, 2020
INTERPOLATED WATER SURFACE ELEVATIONS

MILE	MP	WS 10:00	WS 14:00	MP DIFF 10:00	MP DIFF 14:00
269.0	434.1	446.3	446.4	12.3	12.3
268.0	434.0	446.0	446.0	11.9	11.9
267.0	434.0	445.6	445.6	11.6	11.6
266.0	434.0	445.2	445.2	11.2	11.2
265.0	434.0	444.8	444.8	10.8	10.8

Comprehensive Survey

- Sounded June 9 & 10, 2020 by Prairie Engineers, P.C.
- Horizontal Datum is based on the North American Datum of 1983 (NAD83(2011)). Coordinates shown are Missouri East Zone State Plane.
- Vertical Datum is based on the National Geodetic Vertical Datum of 1929 (NGVD29).

Depths shown are below MINIMUM POOL
Depths shown in red are 3' below MINIMUM POOL
Depths shown in green are 12' below MINIMUM POOL
Depths shown in blue are 14' below MINIMUM POOL

MIN POOL

DEPTHS AND CONTOURS SHOWN ARE BASED ON DEPTH BELOW MINIMUM POOL




US Army Corps
of Engineers
St. Louis District

WATER SURFACE	L & D 24 IL	BRPAP
ZERO NGVD	426.8	426.0
MILE	273.5	265.0
MIN POOL	434.0	434.0
9 JUN 2020	448.10(600)	444.8 10(600)
	448.10(600)	444.8 10(600)

Survey Date: June 9, 2020	Submitted: Chief, Engr. Data Mgt. Sect.
Drawn by: DCC by: DEF	Reviewed by: Chief, Engr. Data Mgt. Sect.
U.S. Army Engineer Division Corps of Engineers St. Louis, Missouri	Upper Mississippi River Basin Mississippi River
U.S. Army Engineer Division Corps of Engineers St. Louis, Missouri	Upper Mississippi River Basin Mississippi River

240 METERS 0 120 240 800 FEET 0 400 800	COMPREHENSIVE SURVEY MILE: 300.0 - 195.0
--	---

PLATE NUMBER
18

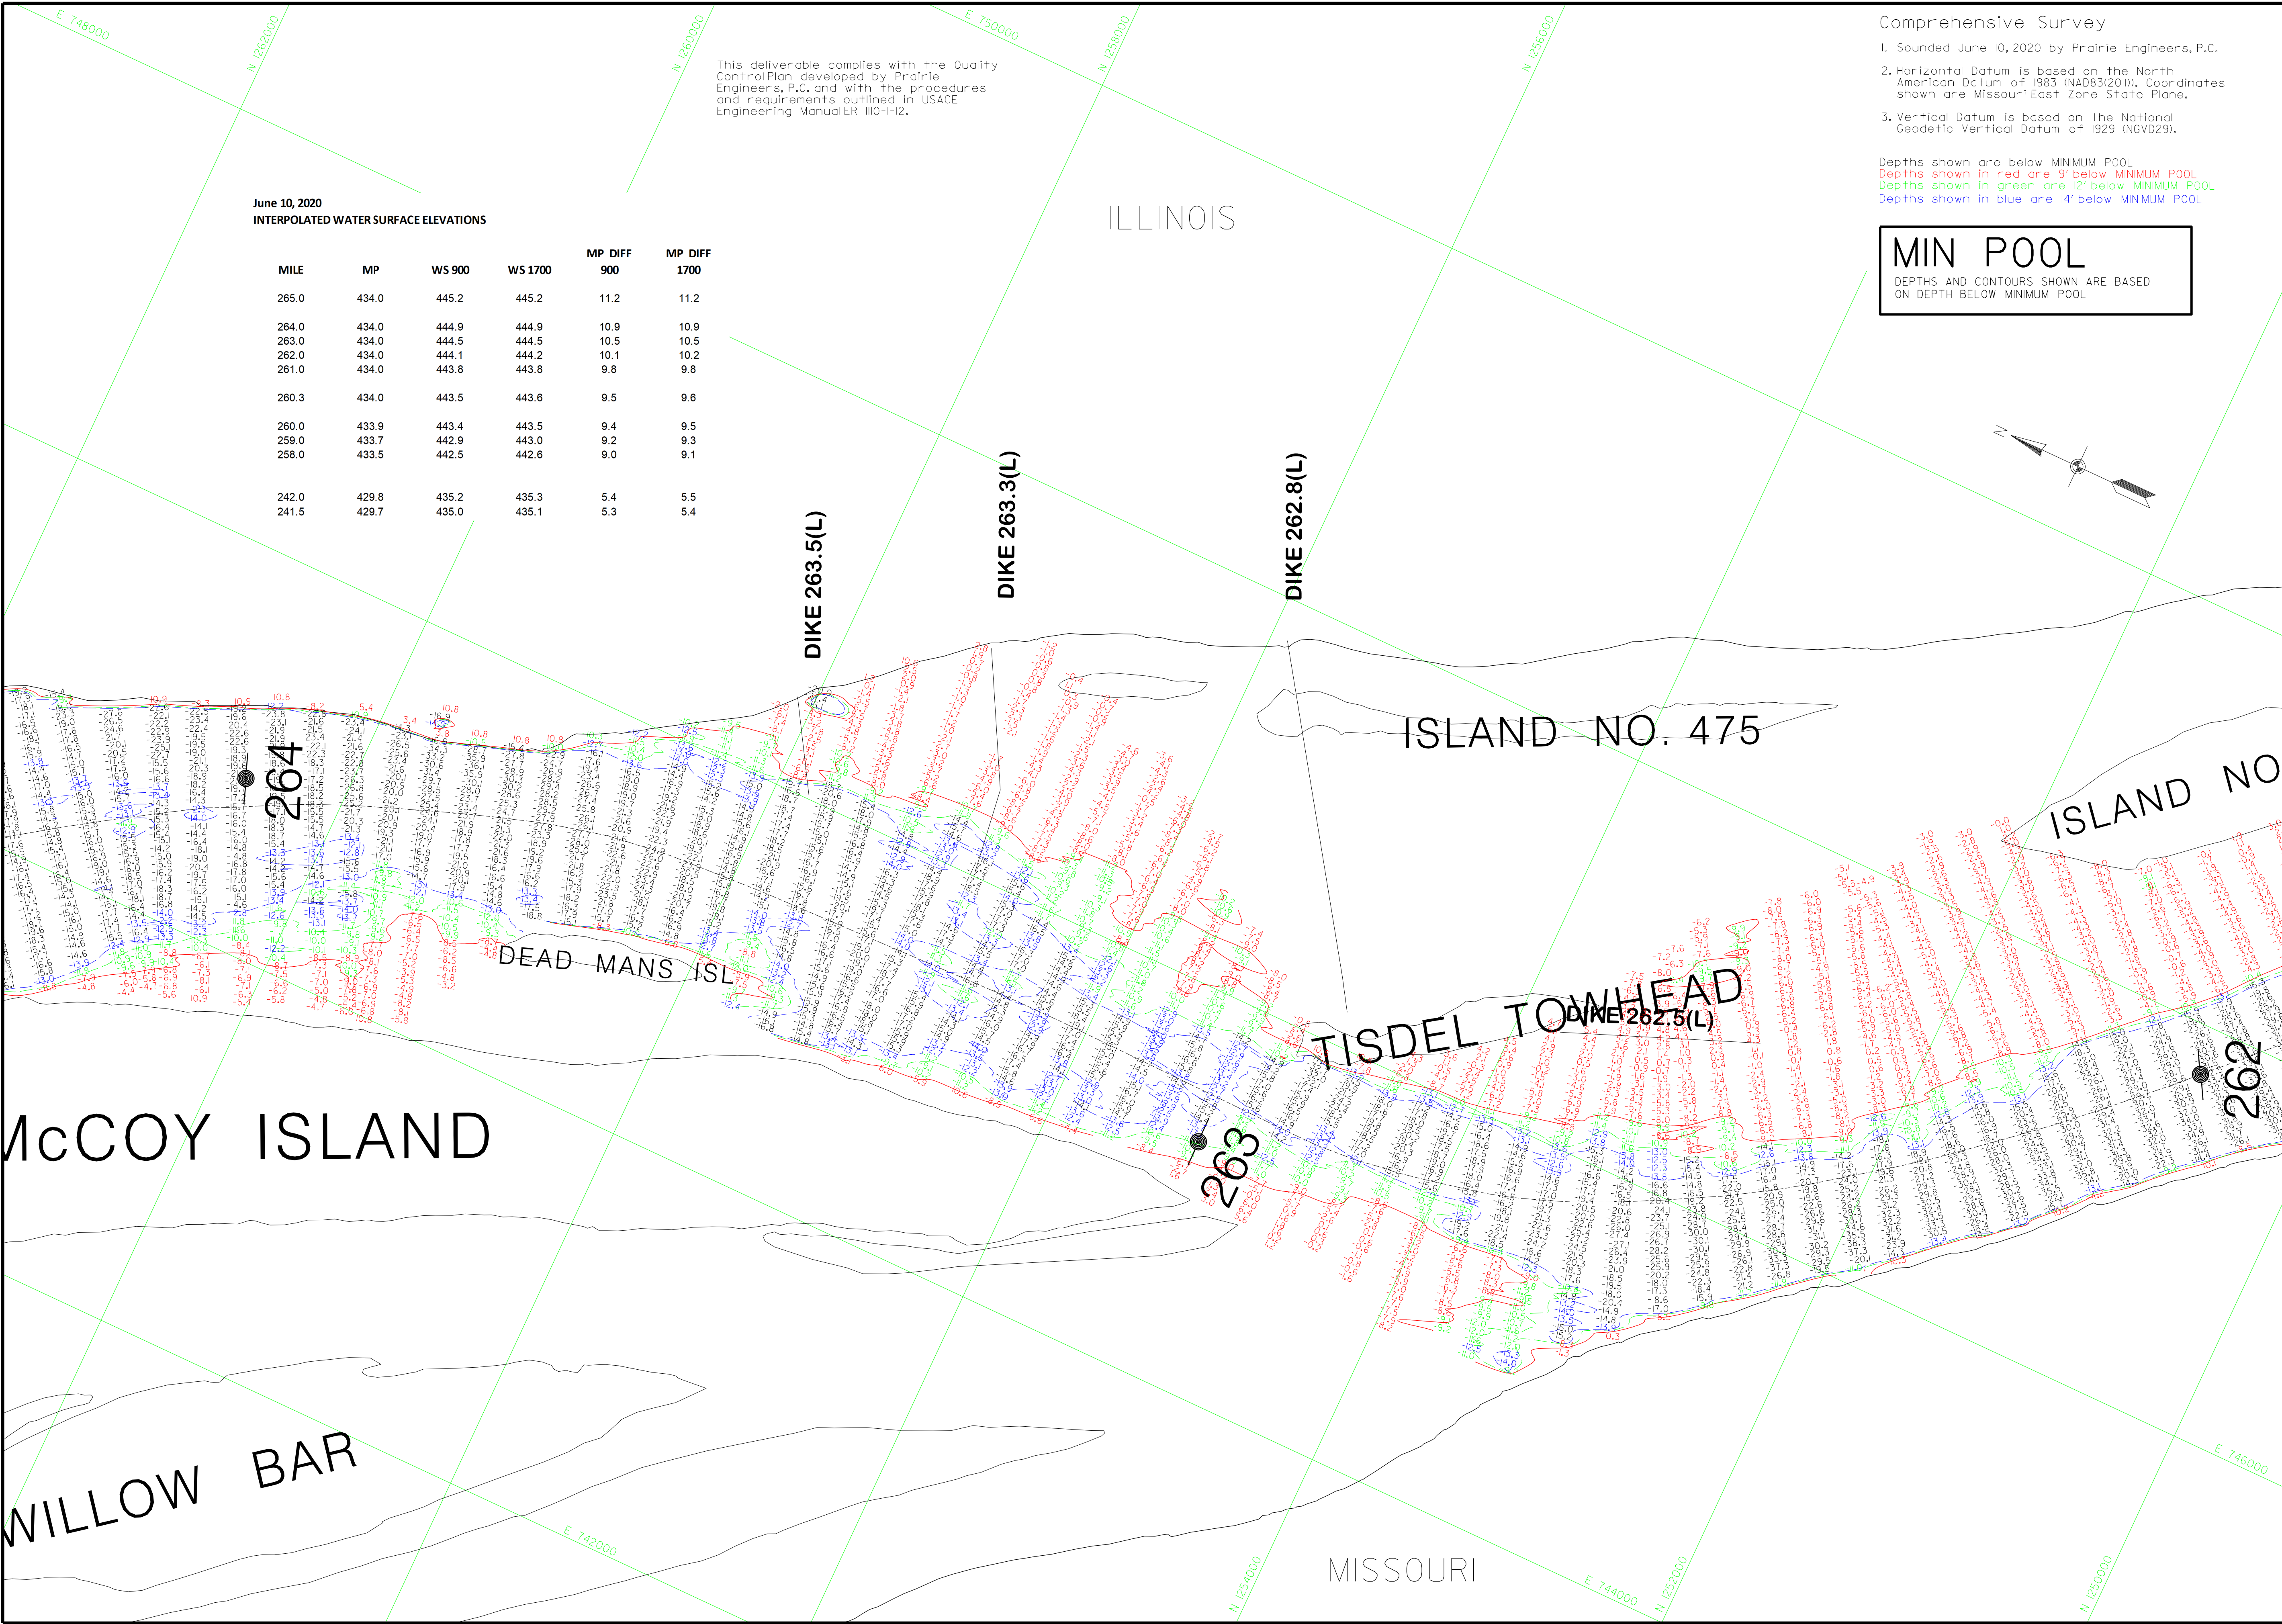

June 10, 2020
INTERPOLATED WATER SURFACE ELEVATIONS

MILE	MP	WS 900	WS 1700	MP DIFF 900	MP DIFF 1700
265.0	434.0	445.2	445.2	11.2	11.2
264.0	434.0	444.9	444.9	10.9	10.9
263.0	434.0	444.5	444.5	10.5	10.5
262.0	434.0	444.1	444.2	10.1	10.2
261.0	434.0	443.8	443.8	9.8	9.8
260.3	434.0	443.5	443.6	9.5	9.6
260.0	433.9	443.4	443.5	9.4	9.5
259.0	433.7	442.9	443.0	9.2	9.3
258.0	433.5	442.5	442.6	9.0	9.1
242.0	429.8	435.2	435.3	5.4	5.5
241.5	429.7	435.0	435.1	5.3	5.4

This deliverable complies with the Quality Control Plan developed by Prairie Engineers, P.C. and with the procedures and requirements outlined in USACE Engineering Manual ER 1110-1-12.

Comprehensive Survey

- Sounded June 10, 2020 by Prairie Engineers, P.C.
- Horizontal Datum is based on the North American Datum of 1983 (NAD83(2011)). Coordinates shown are Missouri East Zone State Plane.
- Vertical Datum is based on the National Geodetic Vertical Datum of 1929 (NGVD29).

Depths shown are below MINIMUM POOL
Depths shown in red are 9' below MINIMUM POOL
Depths shown in green are 12' below MINIMUM POOL
Depths shown in blue are 14' below MINIMUM POOL

MIN POOL

DEPTHS AND CONTOURS SHOWN ARE BASED ON DEPTH BELOW MINIMUM POOL


WATER SURFACE		CASE RECORD	
ZERO NGVD	WATER SURFACE	RECAP	WATER SURFACE
435.0	435.0	435.0	435.0
MIN POOL	434.0	434.0	434.0
10 JUN 2020	445.2 (10600)	445.2 (11500)	445.2 (11500)

Survey Date: June 10, 2020	SUBMITTED:	Chief, Engr. Data Mgt. Sect.
Drawn by: EJS	Reviewed by: DEF	File Name: 13_241.mxd
U.S. ARMY ENGINEER DIVISION CORPS OF ENGINEERS ST. LOUIS, MISSOURI	UPPER MISSISSIPPI RIVER BASIN	MISSISSIPPI RIVER
APPROVED:	Chief, Geospatial Branch	

240 METERS 0 120 240 800 FEET 0 400 800	COMPREHENSIVE SURVEY MILE: 300.0 - 195.0
--	---

PLATE NUMBER 19



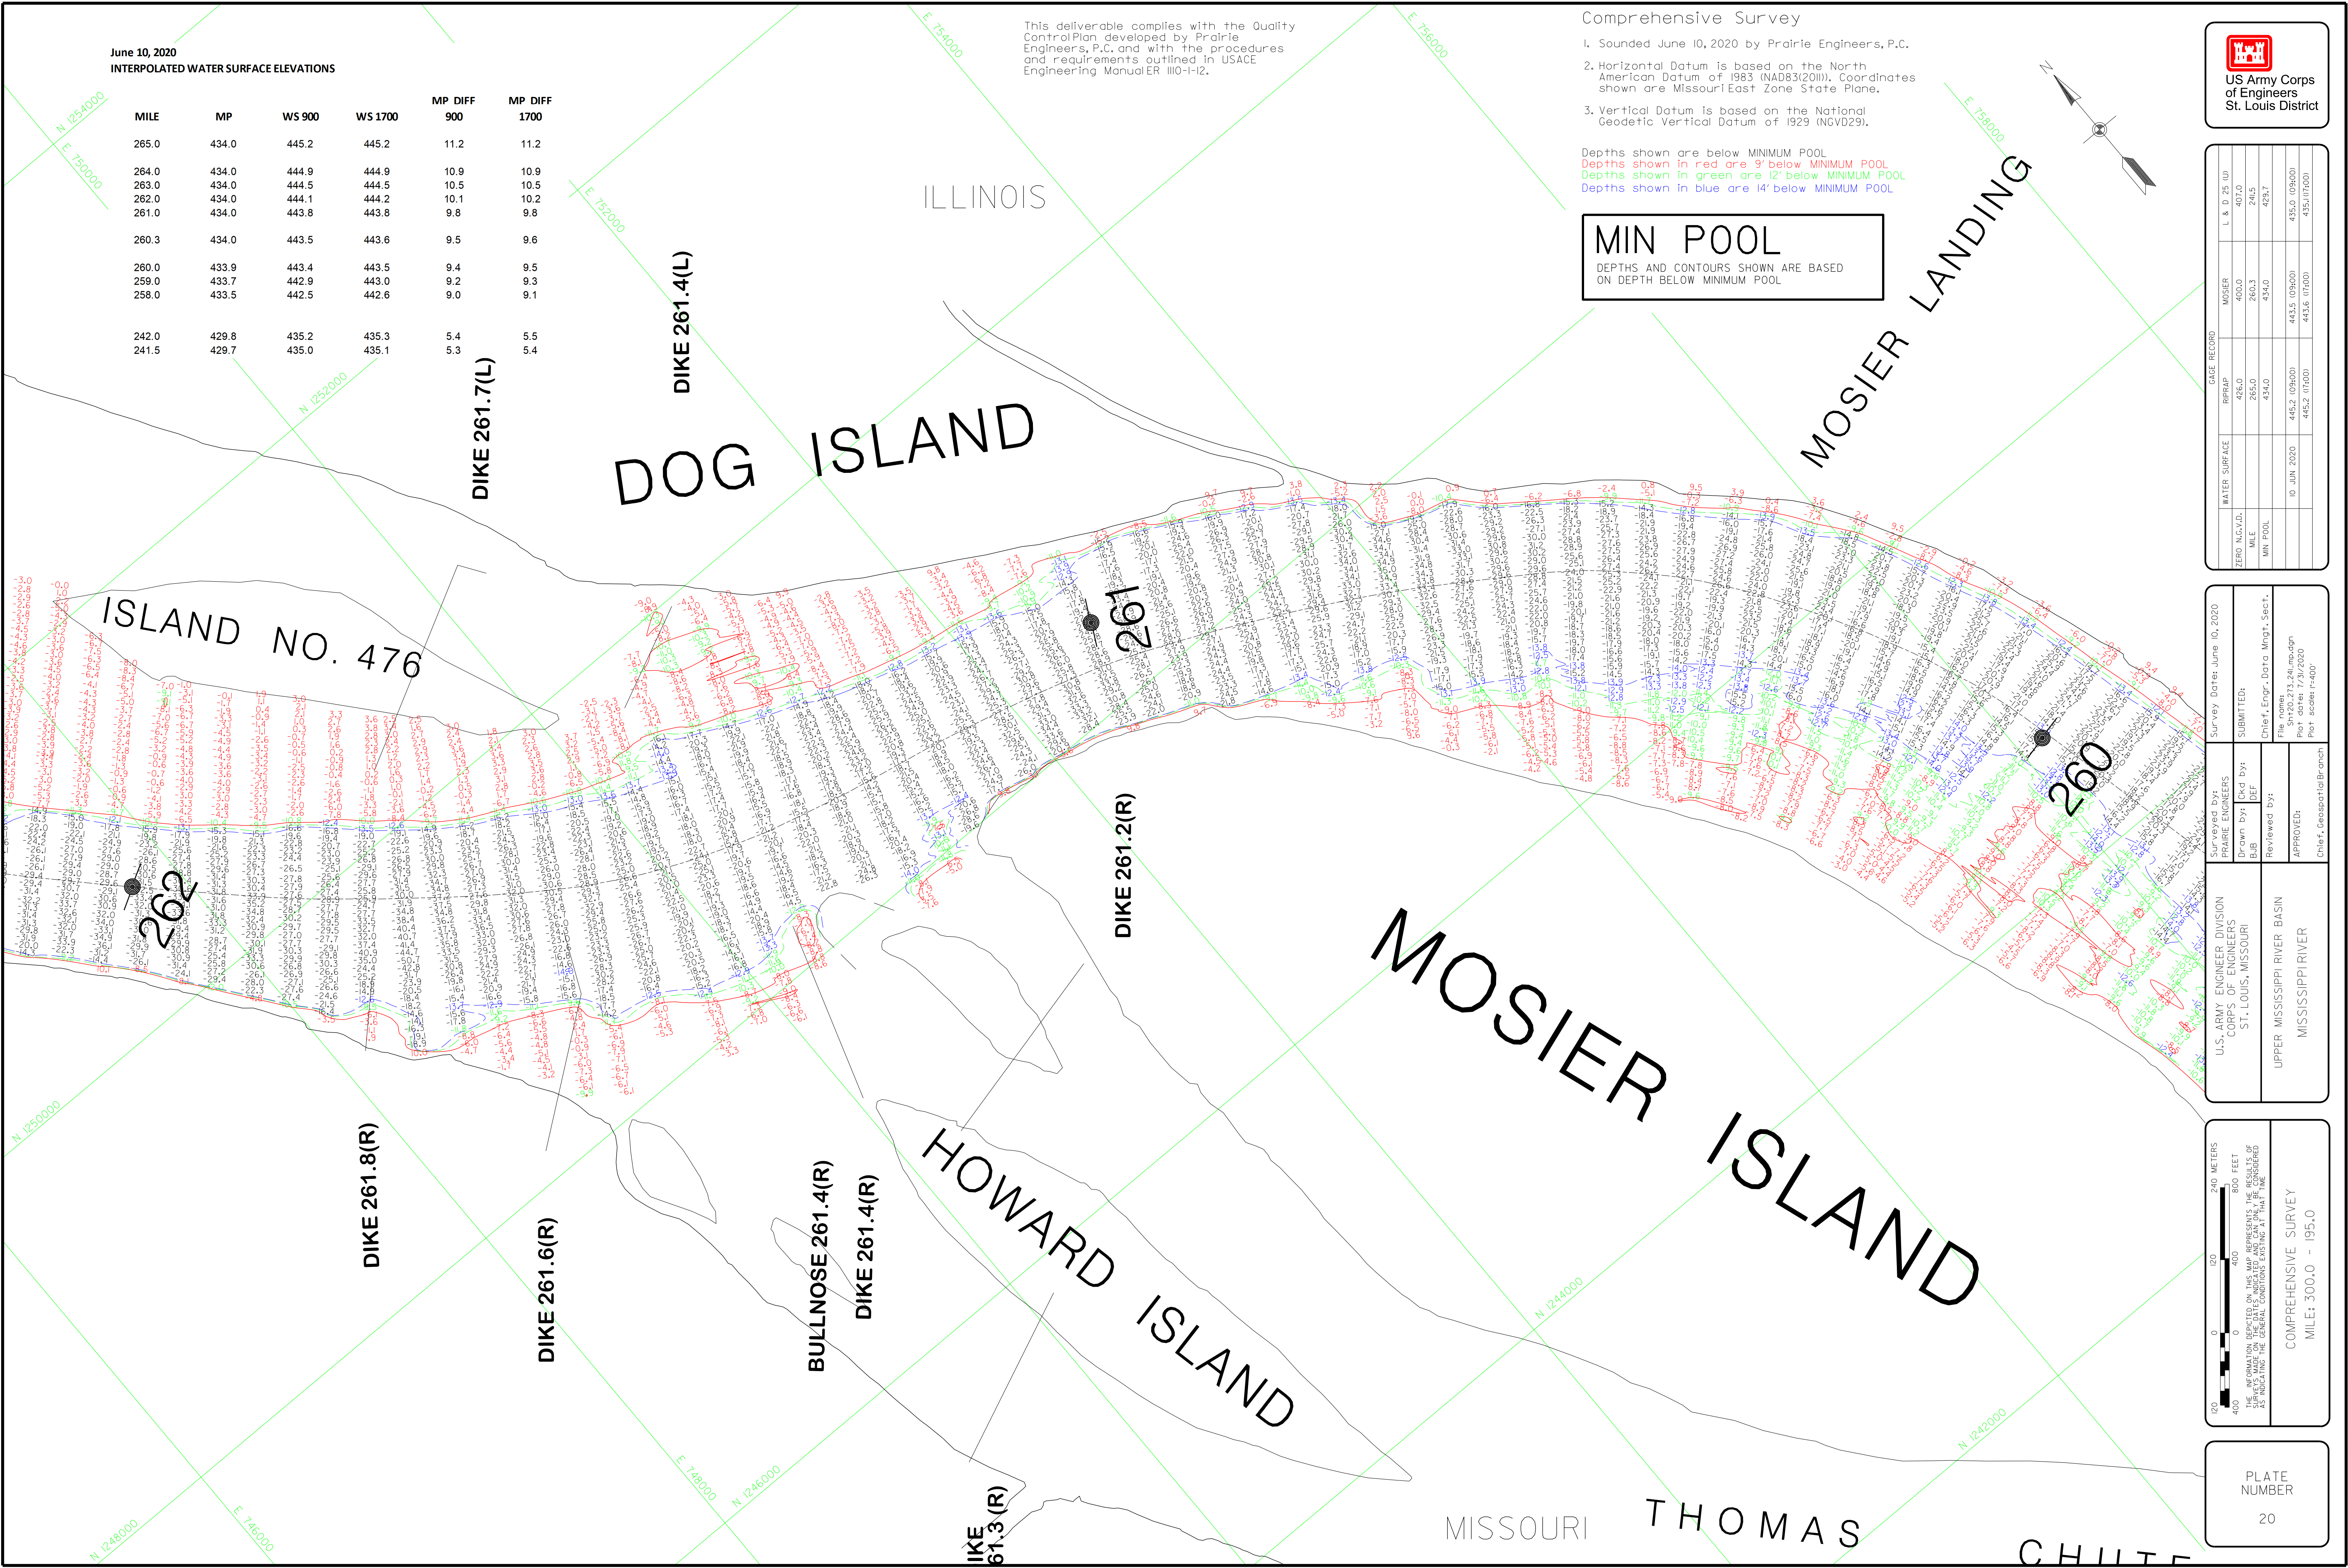

June 10, 2020
INTERPOLATED WATER SURFACE ELEVATIONS

MILE	MP	WS 900	WS 1700	MP DIFF 900	MP DIFF 1700
265.0	434.0	445.2	445.2	11.2	11.2
264.0	434.0	444.9	444.9	10.9	10.9
263.0	434.0	444.5	444.5	10.5	10.5
262.0	434.0	444.1	444.2	10.1	10.2
261.0	434.0	443.8	443.8	9.8	9.8
260.3	434.0	443.5	443.6	9.5	9.6
260.0	433.9	443.4	443.5	9.4	9.5
259.0	433.7	442.9	443.0	9.2	9.3
258.0	433.5	442.5	442.6	9.0	9.1
242.0	429.8	435.2	435.3	5.4	5.5
241.5	429.7	435.0	435.1	5.3	5.4

This deliverable complies with the Quality Control Plan developed by Prairie Engineers, P.C. and with the procedures and requirements outlined in USACE Engineering Manual EM 1110-1-2.

Comprehensive Survey

1. Sounded June 10, 2020 by Prairie Engineers, P.C.
2. Horizontal Datum is based on the North American Datum of 1983 (NAD83(2011)). Coordinates shown are Missouri East Zone State Plane.
3. Vertical Datum is based on the National Geodetic Vertical Datum of 1929 (NGVD29).

Depths shown are below MINIMUM POOL
Depths shown in red are 9' below MINIMUM POOL
Depths shown in green are 12' below MINIMUM POOL
Depths shown in blue are 14' below MINIMUM POOL

MIN POOL
DEPTHS AND CONTOURS SHOWN ARE BASED ON DEPTH BELOW MINIMUM POOL


GAGE RECORD		WOSER	L & D 25 (W)
WATER SURFACE	RRAP	436.0	407.0
ZERO NGVD		263.0	241.5
MILE		434.0	429.7
MIN POOL		445.2 (09600)	435.0 (09600)
		445.2 (11000)	435.0 (11000)

Survey Date: June 10, 2020	SUBMITTED:	
Drawn by: DCD by: DEF	Chief, Engr. Data Mgt. Sect.	
Reviewed by:	File Name: T3.24.mxd	
APPROVED:	Plot Date: 7/31/2020	
Chief, Geospatial Branch	Plot Scale: 1"=400'	

U.S. ARMY ENGINEER DIVISION CORPS OF ENGINEERS ST. LOUIS, MISSOURI	UPPER MISSISSIPPI RIVER BASIN MISSISSIPPI RIVER
--	--

PLATE NUMBER
20

COMPREHENSIVE SURVEY
MILE: 300.0 - 195.0

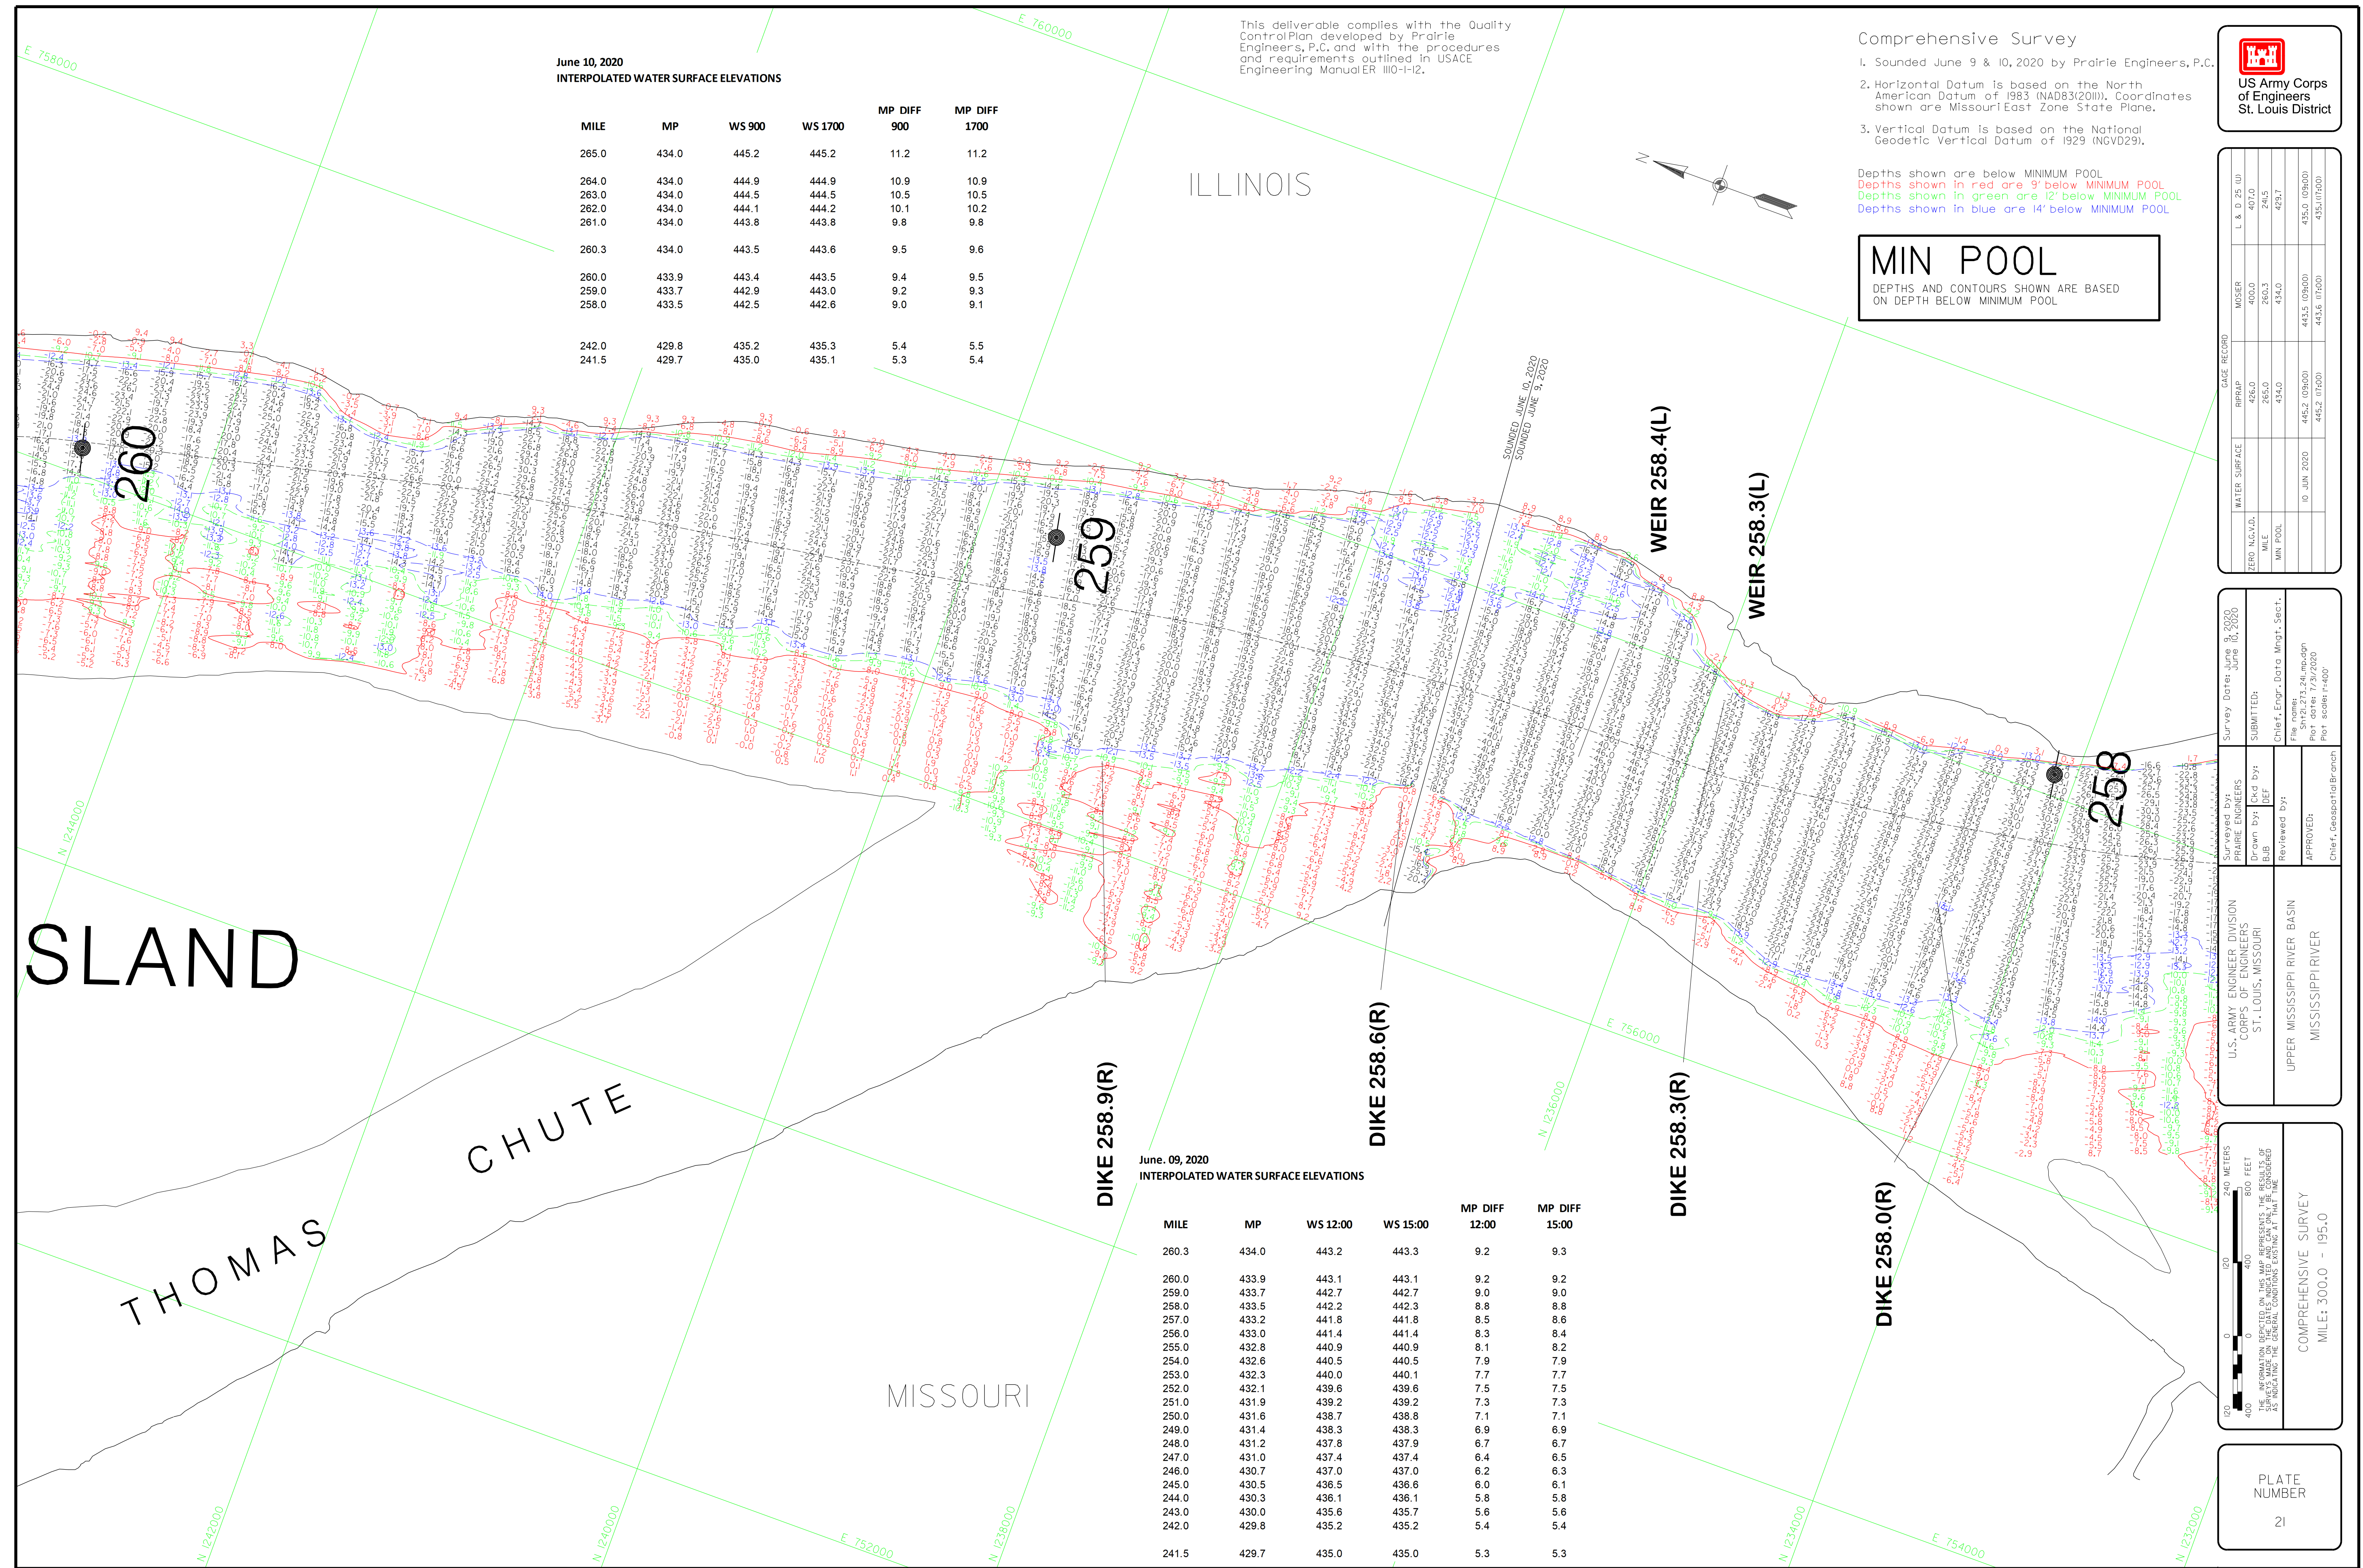

June, 09, 2020
INTERPOLATED WATER SURFACE ELEVATIONS

MILE	MP	WS 12:00	WS 15:00	MP DIFF 12:00	MP DIFF 15:00
260.3	434.0	443.2	443.3	9.2	9.3
260.0	433.9	443.1	443.1	9.2	9.2
259.0	433.7	442.7	442.7	9.0	9.0
258.0	433.5	442.2	442.3	8.8	8.8
257.0	433.2	441.8	441.8	8.5	8.6
256.0	433.0	441.4	441.4	8.3	8.4
255.0	432.8	440.9	440.9	8.1	8.2
254.0	432.6	440.5	440.5	7.9	7.9
253.0	432.3	440.0	440.1	7.7	7.7
252.0	432.1	439.6	439.6	7.5	7.5
251.0	431.9	439.2	439.2	7.3	7.3
250.0	431.6	438.7	438.8	7.1	7.1
249.0	431.4	438.3	438.3	6.9	6.9
248.0	431.2	437.8	437.9	6.7	6.7
247.0	431.0	437.4	437.4	6.4	6.5
246.0	430.7	437.0	437.0	6.2	6.3
245.0	430.5	436.5	436.6	6.0	6.1
244.0	430.3	436.1	436.1	5.8	5.8
243.0	430.0	435.6	435.7	5.6	5.6
242.0	429.8	435.2	435.2	5.4	5.4
241.5	429.7	435.0	435.0	5.3	5.3

May, 29, 2020
INTERPOLATED WATER SURFACE ELEVATIONS

MILE	MP	WS 10:00	WS 13:00	MP DIFF 10:00	MP DIFF 13:00
260.3	434.0	441.9	442.0	7.9	8.0
260.0	433.9	441.8	441.9	7.8	8.0
259.0	433.7	441.3	441.5	7.6	7.8
258.0	433.5	440.9	441.0	7.4	7.6
257.0	433.2	440.5	440.6	7.2	7.4
256.0	433.0	440.1	440.2	7.0	7.2
255.0	432.8	439.6	439.8	6.8	7.0
254.0	432.6	439.2	439.3	6.6	6.8
253.0	432.3	438.8	438.9	6.4	6.6
252.0	432.1	438.4	438.5	6.3	6.4
251.0	431.9	437.9	438.1	6.1	6.2
250.0	431.6	437.5	437.6	5.9	6.0
249.0	431.4	437.1	437.2	5.7	5.8
248.0	431.2	436.7	436.8	5.5	5.6
247.0	431.0	436.2	436.4	5.3	5.4
246.0	430.7	435.8	435.9	5.1	5.2
245.0	430.5	435.4	435.5	4.9	5.0
244.0	430.3	435.0	435.1	4.7	4.8
243.0	430.0	434.5	434.7	4.5	4.6
242.0	429.8	434.1	434.2	4.3	4.4
241.5	429.7	433.9	433.9	4.2	4.2

Comprehensive Survey

- Sounded May 29 & June 9, 2020 by Prairie Engineers, P.C.
- Horizontal Datum is based on the North American Datum of 1983 (NAD83(2011)). Coordinates shown are Missouri East Zone State Plane.
- Vertical Datum is based on the National Geodetic Vertical Datum of 1929 (NGVD29).

Depths shown are below MINIMUM POOL
Depths shown in red are 3' below MINIMUM POOL
Depths shown in green are 12' below MINIMUM POOL
Depths shown in blue are 14' below MINIMUM POOL

MIN POOL


DEPTHS AND CONTOURS SHOWN ARE BASED ON DEPTH BELOW MINIMUM POOL

This deliverable complies with the Quality Control Plan developed by Prairie Engineers, P.C. and with the procedures and requirements outlined in USACE Engineering Manual ER 1110-1-12.



US Army Corps
of Engineers
St. Louis District

GAGE RECORD		
WATER SURFACE	MOSIER	L & D 25 (U)
ZERO NG-V2D,	400.0	407.0
MILE	260.3	244.5
MIN POOL	434.0	429.7
09 JUN 2020	443.2 10:00	435.0 10:00
	443.3 15:00	435.0 15:00

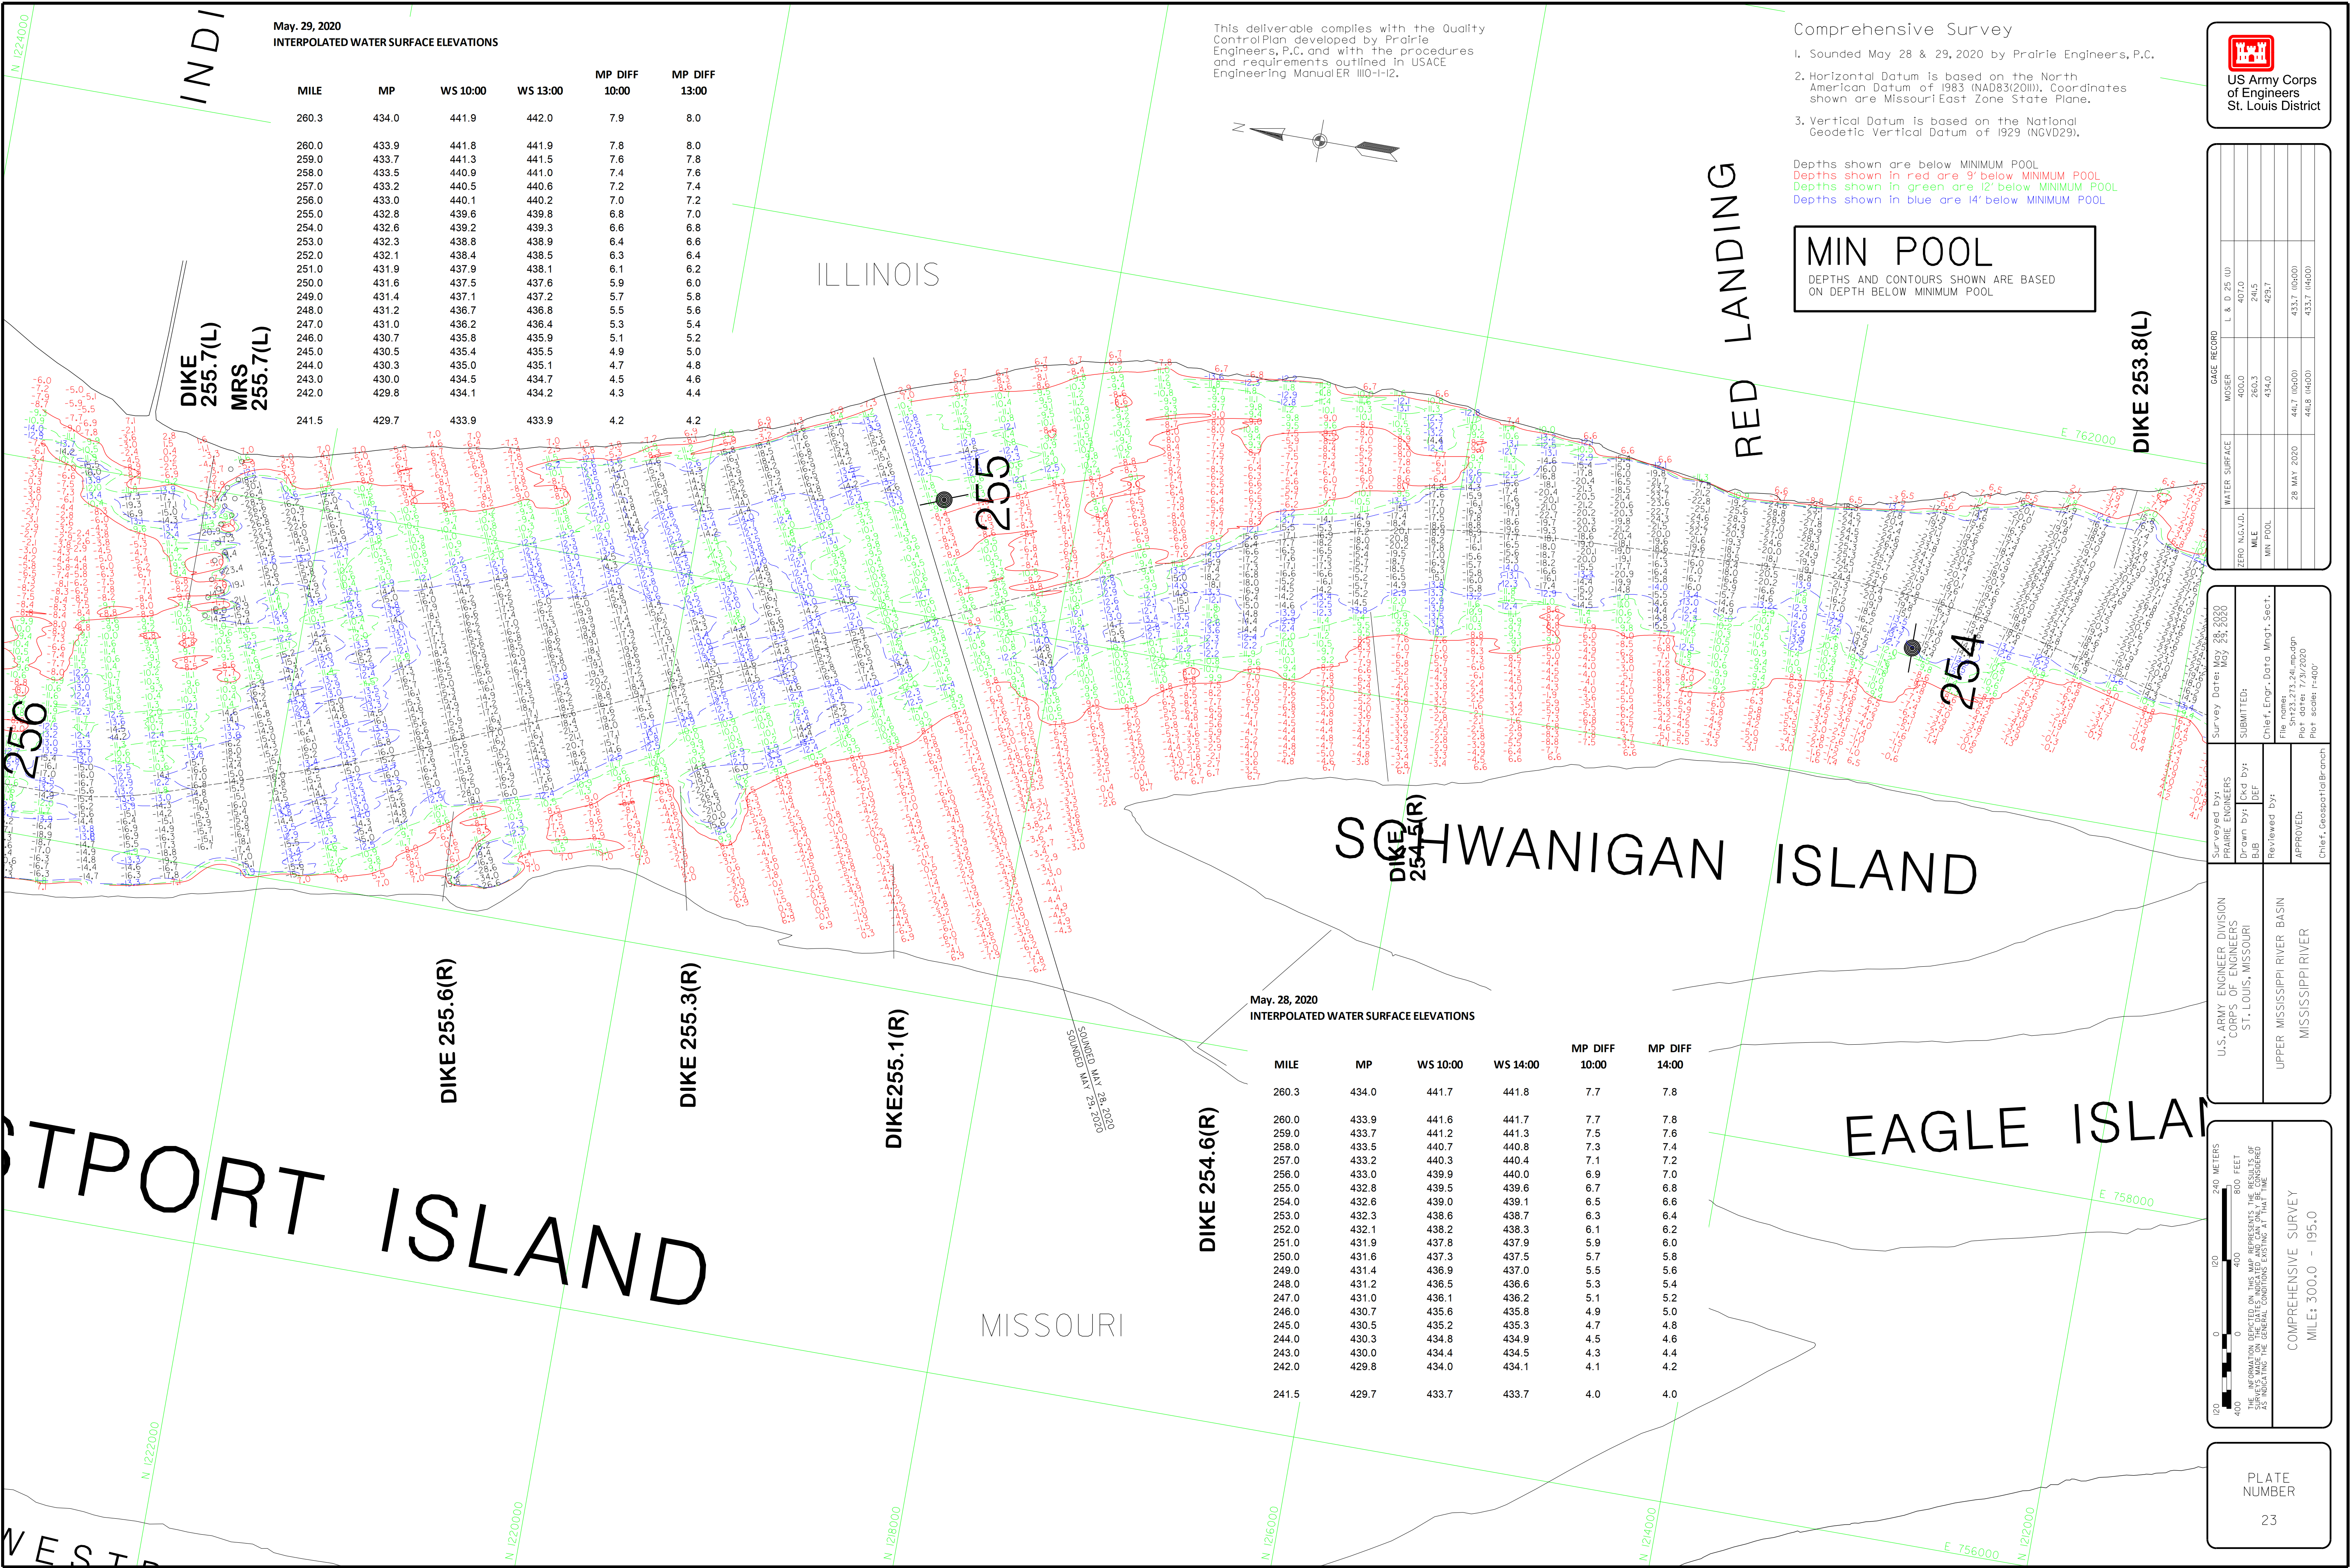

This deliverable complies with the Quality Control Plan developed by Prairie Engineers, P.C. and with the procedures and requirements outlined in USACE Engineering Manual ER 1110-1-12.

Comprehensive Survey

- 1. Sounded May 28 & 29, 2020 by Prairie Engineers, P.C.
- 2. Horizontal Datum is based on the North American Datum of 1983 (NAD83(2011)). Coordinates shown are Missouri East Zone State Plane.
- 3. Vertical Datum is based on the National Geodetic Vertical Datum of 1929 (NGVD29).

Depths shown are below MINIMUM POOL
Depths shown in red are 3' below MINIMUM POOL
Depths shown in green are 12' below MINIMUM POOL
Depths shown in blue are 14' below MINIMUM POOL


MIN POOL
DEPTHS AND CONTOURS SHOWN ARE BASED ON DEPTH BELOW MINIMUM POOL

GAGE RECORD		L & D 25 (U)	
WATER SURFACE		MOSER	
ZERO NGVD		400.0	
MILE		260.3	
MIN POOL		434.0	
		435.7	
		443.7 (H200)	
		443.8 (H200)	

U.S. ARMY ENGINEER DIVISION CORPS OF ENGINEERS ST. LOUIS, MISSOURI		Survey Date: MAY 29, 2020	
UPPER MISSISSIPPI RIVER BASIN		SUBMITTED:	
MISSISSIPPI RIVER		Chief, Engr. Data Mgt. Sect.	
		File Name: 73.241.mxd	
		Plot Date: 7/31/2020	
		Plot Scale: 1"=400'	
		APPROVED:	
		Chief, Geospatial Branch	

240 METERS 800 FEET	
THE INFORMATION DEPICTED ON THIS MAP REPRESENTS THE RESULTS OF A SURVEY CONDUCTED BY PRAIRIE ENGINEERS, P.C. AND IS NOT TO BE CONSIDERED A GUARANTEE OF THE GENERAL CONDITIONS EXISTING AT THE TIME OF THE SURVEY.	
COMPREHENSIVE SURVEY	
MILE: 300.0 - 195.0	

PLATE NUMBER
23

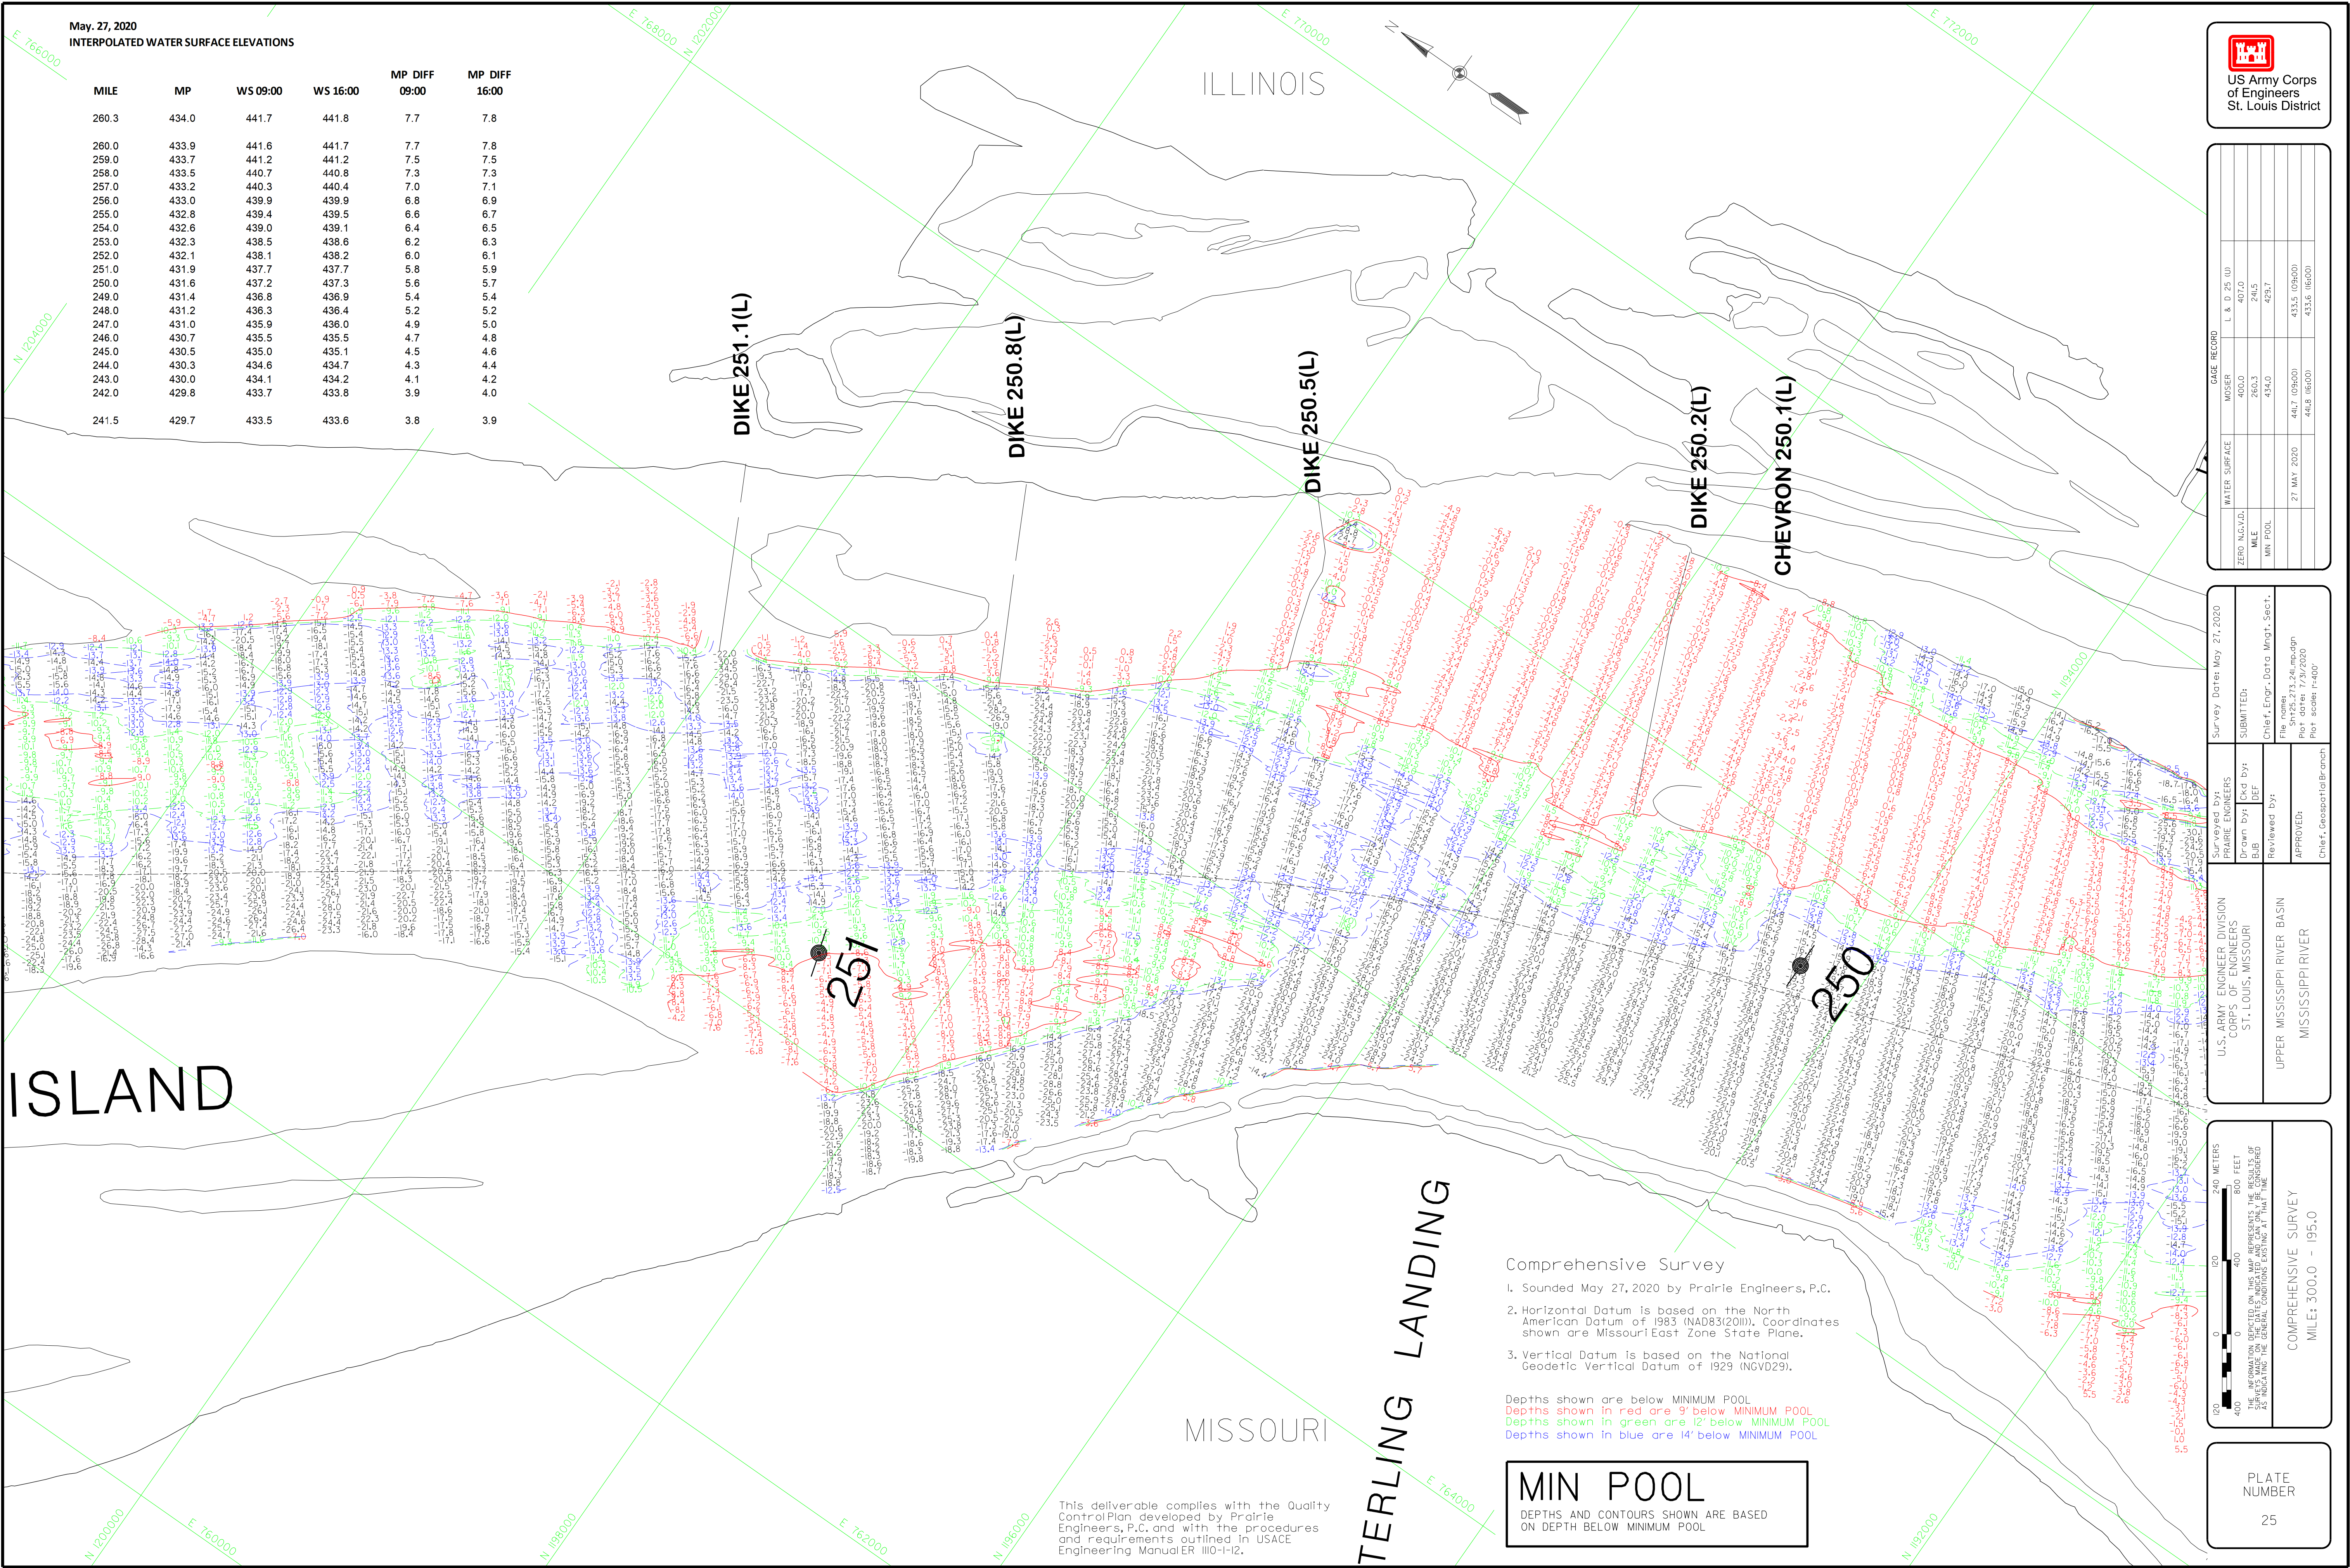

May, 27, 2020
INTERPOLATED WATER SURFACE ELEVATIONS

MILE	MP	WS 09:00	WS 16:00	MP DIFF 09:00	MP DIFF 16:00
260.3	434.0	441.7	441.8	7.7	7.8
260.0	433.9	441.6	441.7	7.7	7.8
259.0	433.7	441.2	441.2	7.5	7.5
258.0	433.5	440.7	440.8	7.3	7.3
257.0	433.2	440.3	440.4	7.0	7.1
256.0	433.0	439.9	439.9	6.8	6.9
255.0	432.8	439.4	439.5	6.6	6.7
254.0	432.6	439.0	439.1	6.4	6.5
253.0	432.3	438.5	438.6	6.2	6.3
252.0	432.1	438.1	438.2	6.0	6.1
251.0	431.9	437.7	437.7	5.8	5.9
250.0	431.6	437.2	437.3	5.6	5.7
249.0	431.4	436.8	436.9	5.4	5.4
248.0	431.2	436.3	436.4	5.2	5.2
247.0	431.0	435.9	436.0	4.9	5.0
246.0	430.7	435.5	435.5	4.7	4.8
245.0	430.5	435.0	435.1	4.5	4.6
244.0	430.3	434.6	434.7	4.3	4.4
243.0	430.0	434.1	434.2	4.1	4.2
242.0	429.8	433.7	433.8	3.9	4.0
241.5	429.7	433.5	433.6	3.8	3.9

- Comprehensive Survey
1. Sounded May 27, 2020 by Prairie Engineers, P.C.
 2. Horizontal Datum is based on the North American Datum of 1983 (NAD83(2011)). Coordinates shown are Missouri East Zone State Plane.
 3. Vertical Datum is based on the National Geodetic Vertical Datum of 1929 (NGVD29).

Depths shown are below MINIMUM POOL
Depths shown in red are 3' below MINIMUM POOL
Depths shown in green are 12' below MINIMUM POOL
Depths shown in blue are 14' below MINIMUM POOL

MIN POOL
DEPTHS AND CONTOURS SHOWN ARE BASED
ON DEPTH BELOW MINIMUM POOL

This deliverable complies with the Quality Control Plan developed by Prairie Engineers, P.C. and with the procedures and requirements outlined in USACE Engineering Manual ER 1110-1-12.



GAGE RECORD		L & D 25 (U)
WATER SURFACE	MOSER	400.0
ZERO M.G.V.D.		400.0
MILE		260.3
MIN POOL		434.0
		429.7
		433.5 (09:00)
		433.6 (16:00)

Survey Date: May 27, 2020		SUBMITTED:	
U.S. ARMY ENGINEER DIVISION CORPS OF ENGINEERS ST. LOUIS, MISSOURI		Chief, Engr. Data Mgt. Sect.	
UPPER MISSISSIPPI RIVER BASIN		File Name: 731241.mxd	
MISSISSIPPI RIVER		Plot Date: 7/31/2020	
		Plot Scale: 1"=400'	
		APPROVED:	
		Chief, Geospatial Branch	

240 METERS	
400 0 400 800 FEET	
THE INFORMATION DEPICTED ON THIS MAP REPRESENTS THE RESULTS OF A SURVEY CONDUCTED UNDER THE GENERAL CONDITIONS EXISTING AT THE TIME OF THE SURVEY.	
COMPREHENSIVE SURVEY	
MILE: 300.0 - 195.0	

PLATE NUMBER
25

E 772000

N 1192000

N 1190000

N 1188000

N 1186000

N 1184000

E 770000

E 766000

E 764000



US Army Corps
of Engineers
St. Louis District

Comprehensive Survey

1. Sounded May 24, 26 & 27, 2020 by Prairie Engineers, P.C.
2. Horizontal Datum is based on the North American Datum of 1983 (NAD83(2011)). Coordinates shown are Missouri East Zone State Plane.
3. Vertical Datum is based on the National Geodetic Vertical Datum of 1929 (NGVD29).

Depths shown are below MINIMUM POOL
Depths shown in red are 9' below MINIMUM POOL
Depths shown in green are 12' below MINIMUM POOL
Depths shown in blue are 14' below MINIMUM POOL

MIN POOL

DEPTHS AND CONTOURS SHOWN ARE BASED ON DEPTH BELOW MINIMUM POOL

This deliverable complies with the Quality Control Plan developed by Prairie Engineers, P.C. and with the procedures and requirements outlined in USACE Engineering Manual ER 1110-I-12.

GAGE RECORD		L & D 25 (U)
WATER SURFACE	MOSER	
ZERO NGVD	400.0	407.0
MILE	260.3	241.5
MIN POOL	434.0	423.7
	26 MAY 2020	433.3 (03:00)
		433.3 (03:00)

Survey Dates: May 24, 2020 May 26, 2020 May 27, 2020		SUBMITTED: Chief, Engr. Data Mgt. Sect. File path: 73.24-mc-dgn Plot date: 7/31/2020 Plot scale: 1"=400'	
Surveyed by: PRAIRIE ENGINEERS	Drawn by: BEB	APPROVED: Chief, Geospatial Branch	
U.S. ARMY ENGINEER DIVISION CORPS OF ENGINEERS ST. LOUIS, MISSOURI		UPPER MISSISSIPPI RIVER BASIN MISSISSIPPI RIVER	

May, 27, 2020
INTERPOLATED WATER SURFACE ELEVATIONS


MILE	MP	WS 09:00	WS 16:00	MP DIFF 09:00	MP DIFF 16:00
260.3	434.0	441.7	441.8	7.7	7.8
260.0	433.9	441.6	441.7	7.7	7.8
259.0	433.7	441.2	441.2	7.5	7.5
258.0	433.5	440.7	440.8	7.3	7.3
257.0	433.2	440.3	440.4	7.0	7.1
256.0	433.0	439.9	439.9	6.8	6.9
255.0	432.8	439.4	439.5	6.6	6.7
254.0	432.6	439.0	439.1	6.4	6.5
253.0	432.3	438.5	438.6	6.2	6.3
252.0	432.1	438.1	438.2	6.0	6.1
251.0	431.9	437.7	437.7	5.8	5.9
250.0	431.6	437.2	437.3	5.6	5.7
249.0	431.4	436.8	436.9	5.4	5.4
248.0	431.2	436.3	436.4	5.2	5.2
247.0	431.0	435.9	436.0	4.9	5.0
246.0	430.7	435.5	435.5	4.7	4.8
245.0	430.5	435.0	435.1	4.5	4.6
244.0	430.3	434.6	434.7	4.3	4.4
243.0	430.0	434.1	434.2	4.1	4.2
242.0	429.8	433.7	433.8	3.9	4.0
241.5	429.7	433.5	433.6	3.8	3.9

May, 26, 2020
INTERPOLATED WATER SURFACE ELEVATIONS

MILE	MP	WS 10:00	WS 13:00	MP DIFF 10:00	MP DIFF 13:00
260.3	434.0	441.7	441.7	7.7	7.7
260.0	433.9	441.6	441.5	7.6	7.6
259.0	433.7	441.1	441.1	7.4	7.4
258.0	433.5	440.7	440.7	7.2	7.2
257.0	433.2	440.2	440.2	7.0	7.0
256.0	433.0	439.8	439.8	6.8	6.7
255.0	432.8	439.3	439.3	6.5	6.5
254.0	432.6	438.9	438.9	6.3	6.3
253.0	432.3	438.4	438.4	6.1	6.1
252.0	432.1	438.0	438.0	5.9	5.9
251.0	431.9	437.5	437.5	5.7	5.7
250.0	431.6	437.1	437.1	5.4	5.4
249.0	431.4	436.6	436.6	5.2	5.2
248.0	431.2	436.2	436.2	5.0	5.0
247.0	431.0	435.8	435.7	4.8	4.8
246.0	430.7	435.3	435.3	4.6	4.6
245.0	430.5	434.9	434.9	4.4	4.4
244.0	430.3	434.4	434.4	4.1	4.1
243.0	430.0	434.0	434.0	3.9	3.9
242.0	429.8	433.5	433.5	3.7	3.7
241.5	429.7	433.3	433.3	3.6	3.6

May 24, 2020
INTERPOLATED WATER SURFACE ELEVATIONS


MILE	MP	WS 1400	WS 2000	MP DIFF 1400	MP DIFF 2000
260.3	434.0	440.1	440.1	6.1	6.1
260.0	433.9	440.0	440.0	6.0	6.0
259.0	433.7	439.5	439.5	5.8	5.7
258.0	433.5	439.0	438.9	5.5	5.5
257.0	433.2	438.5	438.4	5.2	5.2
256.0	433.0	438.0	437.9	4.9	4.9
255.0	432.8	437.5	437.4	4.7	4.6
254.0	432.6	437.0	436.9	4.4	4.4
253.0	432.3	436.5	436.4	4.1	4.1
252.0	432.1	436.0	435.9	3.9	3.8
251.0	431.9	435.5	435.4	3.6	3.5
250.0	431.6	435.0	434.9	3.3	3.3
249.0	431.4	434.5	434.4	3.0	3.0
248.0	431.2	434.0	433.9	2.8	2.7
247.0	431.0	433.5	433.4	2.5	2.4
246.0	430.7	433.0	432.9	2.2	2.1
245.0	430.5	432.5	432.4	2.0	1.9
244.0	430.3	432.0	431.9	1.7	1.6
243.0	430.0	431.5	431.4	1.4	1.3
242.0	429.8	431.0	430.9	1.1	1.0
241.5	429.7	430.7	430.6	1.0	0.9

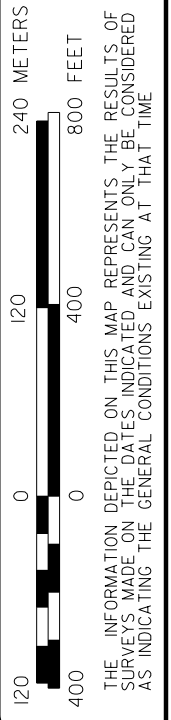

COMPREHENSIVE SURVEY
MILE: 300.0 - 195.0

PLATE
NUMBER

26

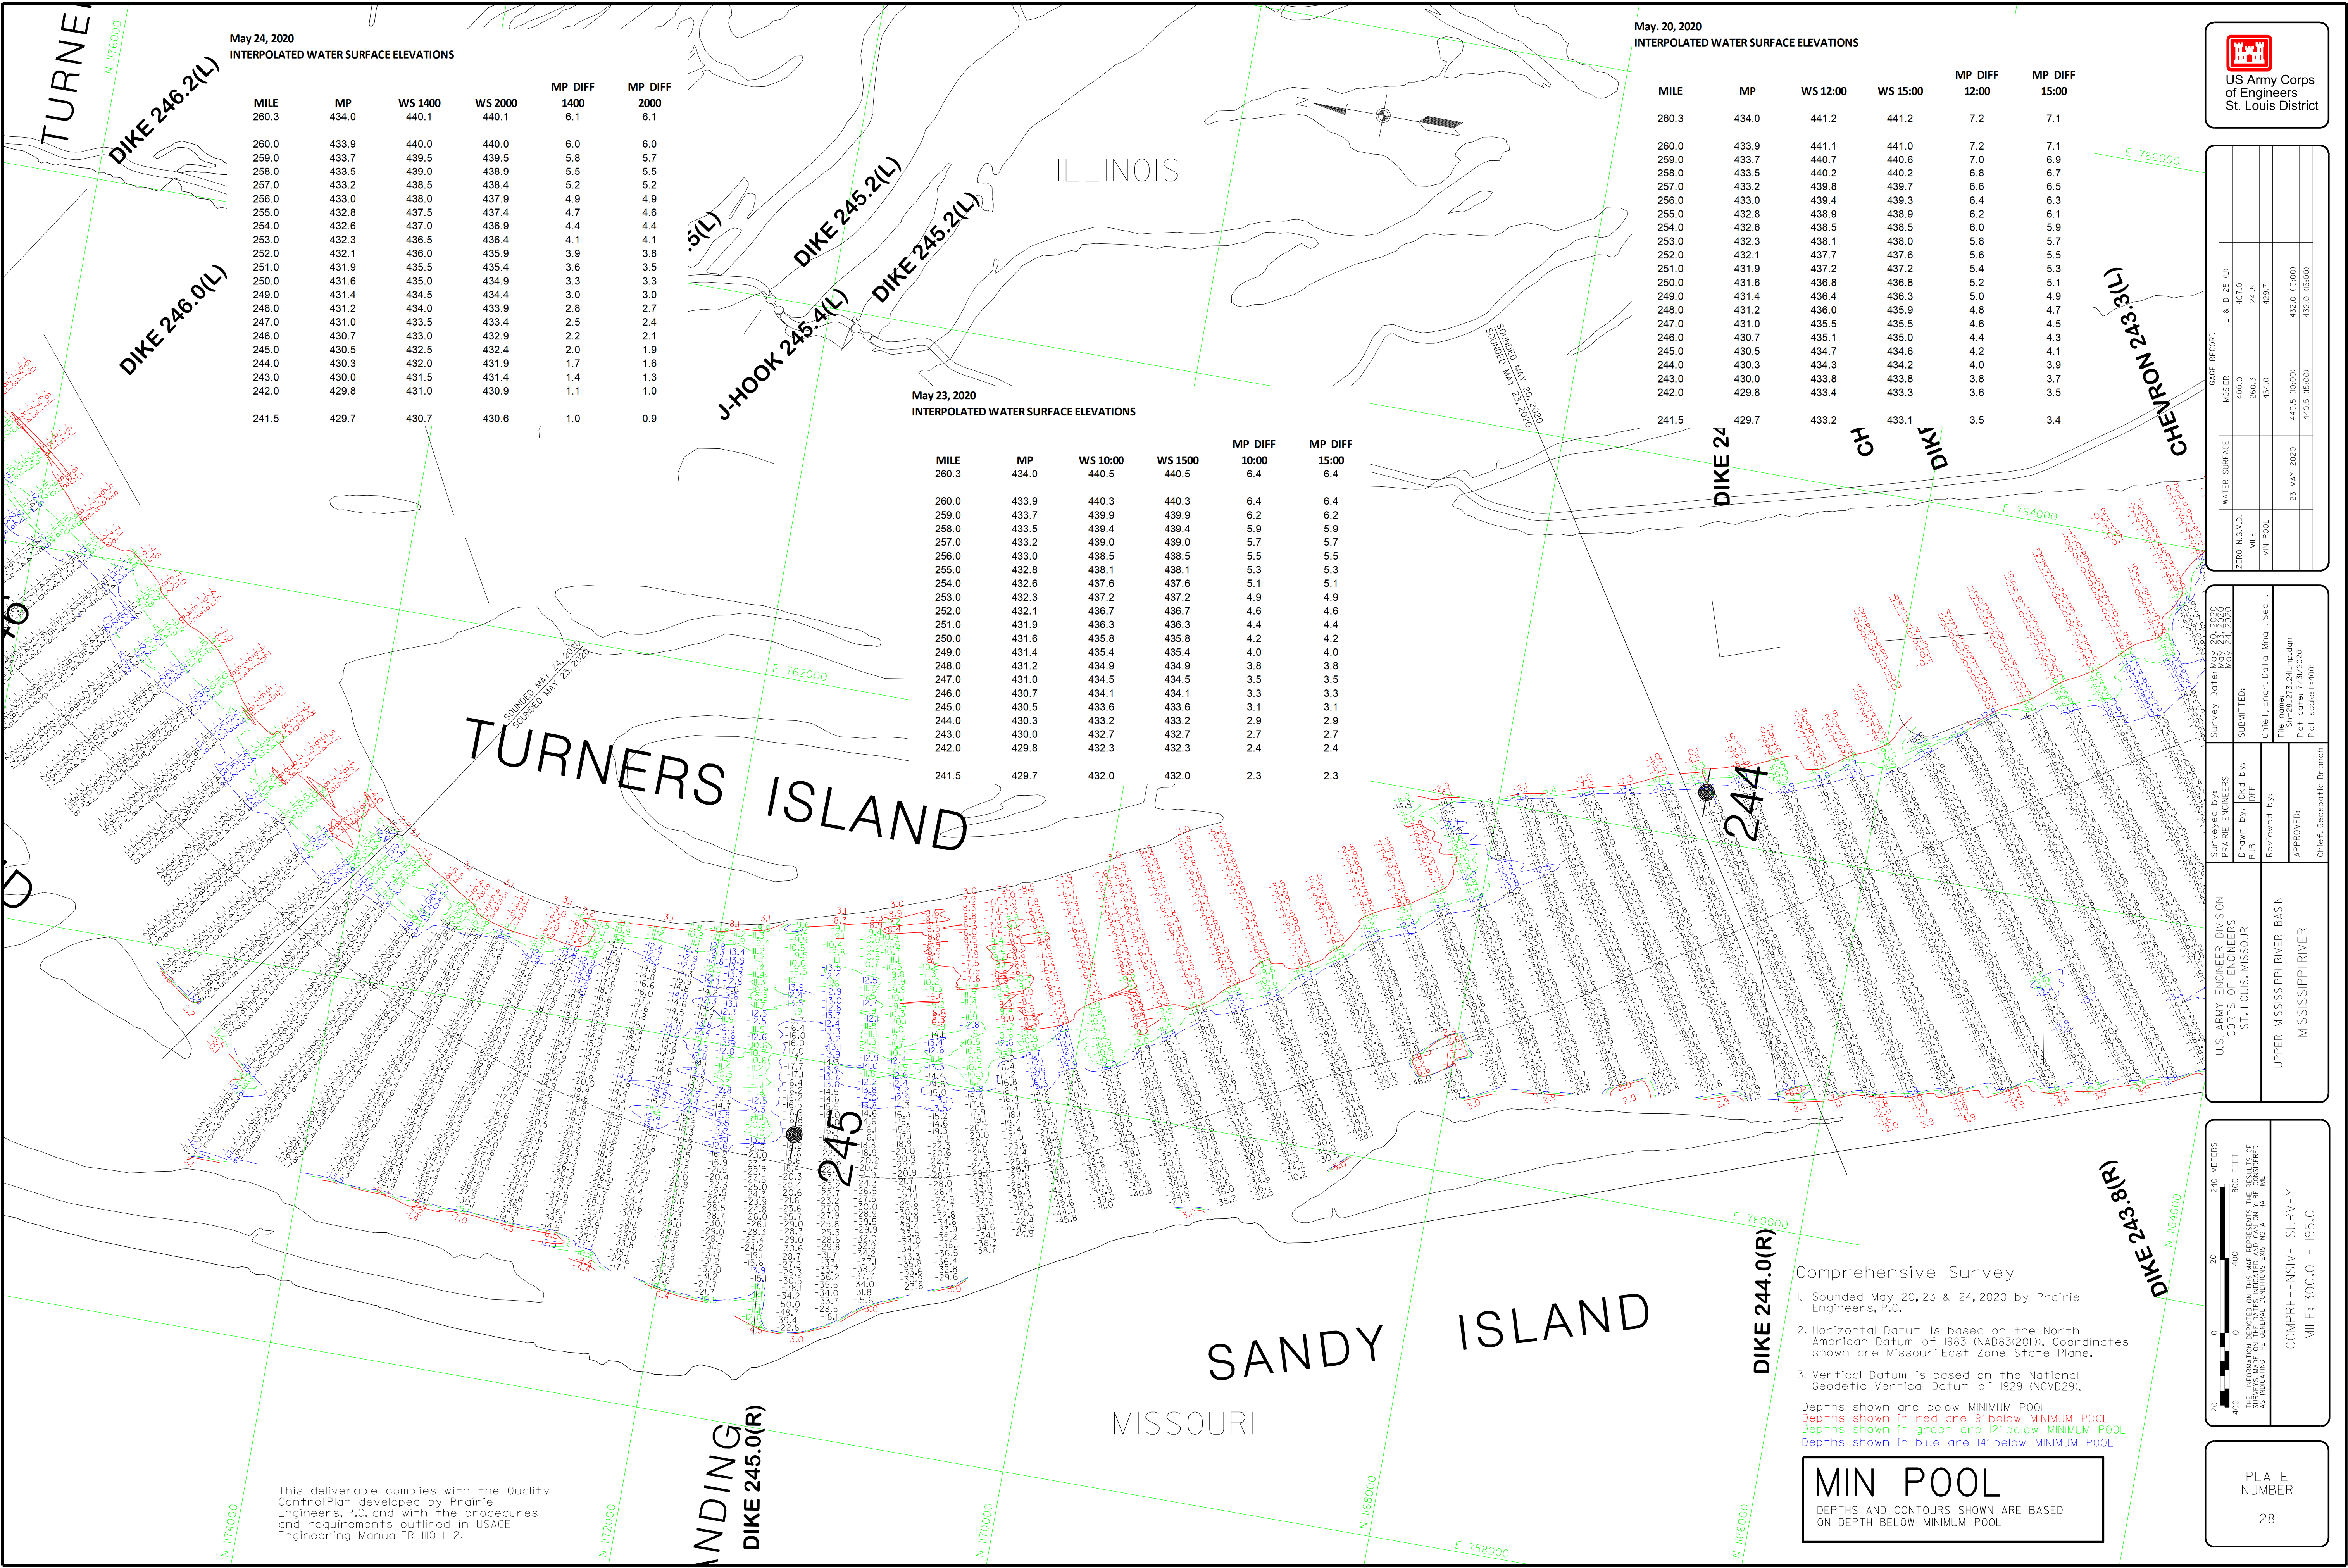

May 24, 2020
INTERPOLATED WATER SURFACE ELEVATIONS

MILE	MP	WS 1400	WS 2000	MP DIFF 1400	MP DIFF 2000
260.3	434.0	440.1	440.1	6.1	6.1
260.0	433.9	440.0	440.0	6.0	6.0
259.0	433.7	439.5	439.5	5.8	5.7
258.0	433.5	439.0	438.9	5.5	5.5
257.0	433.2	438.5	438.4	5.2	5.2
256.0	433.0	438.0	437.9	4.9	4.9
255.0	432.8	437.5	437.4	4.7	4.6
254.0	432.6	437.0	436.9	4.4	4.4
253.0	432.3	436.5	436.4	4.1	4.1
252.0	432.1	436.0	435.9	3.9	3.8
251.0	431.9	435.5	435.4	3.6	3.5
250.0	431.6	435.0	434.9	3.3	3.3
249.0	431.4	434.5	434.4	3.0	3.0
248.0	431.2	434.0	433.9	2.8	2.7
247.0	431.0	433.5	433.4	2.5	2.4
246.0	430.7	433.0	432.9	2.2	2.1
245.0	430.5	432.5	432.4	2.0	1.9
244.0	430.3	432.0	431.9	1.7	1.6
243.0	430.0	431.5	431.4	1.4	1.3
242.0	429.8	431.0	430.9	1.1	1.0
241.5	429.7	430.7	430.6	1.0	0.9

May 23, 2020
INTERPOLATED WATER SURFACE ELEVATIONS

MILE	MP	WS 10:00	WS 1500	MP DIFF 10:00	MP DIFF 15:00
260.3	434.0	440.5	440.5	6.4	6.4
260.0	433.9	440.3	440.3	6.4	6.4
259.0	433.7	439.9	439.9	6.2	6.2
258.0	433.5	439.4	439.4	5.9	5.9
257.0	433.2	439.0	439.0	5.7	5.7
256.0	433.0	438.5	438.5	5.5	5.5
255.0	432.8	438.1	438.1	5.3	5.3
254.0	432.6	437.6	437.6	5.1	5.1
253.0	432.3	437.2	437.2	4.9	4.9
252.0	432.1	436.7	436.7	4.6	4.6
251.0	431.9	436.3	436.3	4.4	4.4
250.0	431.6	435.8	435.8	4.2	4.2
249.0	431.4	435.4	435.4	4.0	4.0
248.0	431.2	434.9	434.9	3.8	3.8
247.0	431.0	434.5	434.5	3.5	3.5
246.0	430.7	434.1	434.1	3.3	3.3
245.0	430.5	433.6	433.6	3.1	3.1
244.0	430.3	433.2	433.2	2.9	2.9
243.0	430.0	432.7	432.7	2.7	2.7
242.0	429.8	432.3	432.3	2.4	2.4
241.5	429.7	432.0	432.0	2.3	2.3

May 20, 2020
INTERPOLATED WATER SURFACE ELEVATIONS

MILE	MP	WS 12:00	WS 15:00	MP DIFF 12:00	MP DIFF 15:00
260.3	434.0	441.2	441.2	7.2	7.1
260.0	433.9	441.1	441.0	7.2	7.1
259.0	433.7	440.7	440.6	7.0	6.9
258.0	433.5	440.2	440.2	6.8	6.7
257.0	433.2	439.8	439.7	6.6	6.5
256.0	433.0	439.4	439.3	6.4	6.3
255.0	432.8	438.9	438.9	6.2	6.1
254.0	432.6	438.5	438.5	6.0	5.9
253.0	432.3	438.1	438.0	5.8	5.7
252.0	432.1	437.7	437.6	5.6	5.5
251.0	431.9	437.2	437.2	5.4	5.3
250.0	431.6	436.8	436.8	5.2	5.1
249.0	431.4	436.4	436.3	5.0	4.9
248.0	431.2	436.0	435.9	4.8	4.7
247.0	431.0	435.5	435.5	4.6	4.5
246.0	430.7	435.1	435.0	4.4	4.3
245.0	430.5	434.7	434.6	4.2	4.1
244.0	430.3	434.3	434.2	4.0	3.9
243.0	430.0	433.8	433.8	3.8	3.7
242.0	429.8	433.4	433.3	3.6	3.5
241.5	429.7	433.2	433.1	3.5	3.4

This deliverable complies with the Quality Control Plan developed by Prairie Engineers, P.C. and with the procedures and requirements outlined in USACE Engineering Manual EM 110-1-12.

Comprehensive Survey

- Sounded May 20, 23 & 24, 2020 by Prairie Engineers, P.C.
- Horizontal Datum is based on the North American Datum of 1983 (NAD83(2011)). Coordinates shown are Missouri East Zone State Plane.
- Vertical Datum is based on the National Geodetic Vertical Datum of 1929 (NGVD29).

Depths shown are below MINIMUM POOL
Depths shown in red are 9' below MINIMUM POOL
Depths shown in green are 12' below MINIMUM POOL
Depths shown in blue are 14' below MINIMUM POOL

MIN POOL

DEPTHS AND CONTOURS SHOWN ARE BASED ON DEPTH BELOW MINIMUM POOL



US Army Corps
of Engineers
St. Louis District

DATE	RECORD	L & D 25' UP
WATER SURFACE	MSR	400.0
ZERO NADVD	MSR	260.3
MILE	MIN POOL	434.0
23 MAY 2020		440.5 (0500)
		440.5 (0500)

Survey Dates	May 20, 2020	May 23, 2020	May 24, 2020
SUBMITTED:			
Chief, Engr. Data Mgt. Sect.			
Plot dates: 7/31/2020			
Plot scale: 1"=400'			

U.S. ARMY ENGINEER DIVISION	U.S. ARMY ENGINEERS	Drawn by:	Exc by:
CORPS OF ENGINEERS	PAIRIE ENGINEERS	DB	DB
ST. LOUIS, MISSOURI		REP	REP
UPPER MISSISSIPPI RIVER BASIN			
MISSISSIPPI RIVER			

U.S. ARMY ENGINEER DIVISION	U.S. ARMY ENGINEERS	Drawn by:	Exc by:
CORPS OF ENGINEERS	PAIRIE ENGINEERS	DB	DB
ST. LOUIS, MISSOURI		REP	REP
UPPER MISSISSIPPI RIVER BASIN			
MISSISSIPPI RIVER			

COMPREHENSIVE SURVEY	COMPREHENSIVE SURVEY
MILE: 300.0 - 195.0	MILE: 300.0 - 195.0

PLATE NUMBER	28
--------------	----

Comprehensive Survey

1. Sounded May 19, 20 & June 10, 2020 by Prairie Engineers, P.C.
2. Horizontal Datum is based on the North American Datum of 1983 (NAD83(2011)). Coordinates shown are Missouri East Zone State Plane.
3. Vertical Datum is based on the National Geodetic Vertical Datum of 1929 (NGVD29).
- Depths shown are below MINIMUM POOL
Depths shown in red are 9' below MINIMUM POOL
Depths shown in green are 12' below MINIMUM POOL
Depths shown in blue are 14' below MINIMUM POOL

MIN POOL
DEPTHS AND CONTOURS SHOWN ARE BASED ON DEPTH BELOW MINIMUM POOL

May, 20, 2020
INTERPOLATED WATER SURFACE ELEVATIONS

MILE	MP	WS 12:00	WS 15:00	MP DIFF 12:00	MP DIFF 15:00
260.3	434.0	441.2	441.2	7.2	7.1
260.0	433.9	441.1	441.0	7.2	7.1
259.0	433.7	440.7	440.6	7.0	6.9
258.0	433.5	440.2	440.2	6.8	6.7
257.0	433.2	439.8	439.7	6.6	6.5
256.0	433.0	439.4	439.3	6.4	6.3
255.0	432.8	438.9	438.9	6.2	6.1
254.0	432.6	438.5	438.5	6.0	5.9
253.0	432.3	438.1	438.0	5.8	5.7
252.0	432.1	437.7	437.6	5.6	5.5
251.0	431.9	437.2	437.2	5.4	5.3
250.0	431.6	436.8	436.8	5.2	5.1
249.0	431.4	436.4	436.3	5.0	4.9
248.0	431.2	436.0	435.9	4.8	4.7
247.0	431.0	435.5	435.5	4.6	4.5
246.0	430.7	435.1	435.0	4.4	4.3
245.0	430.5	434.7	434.6	4.2	4.1
244.0	430.3	434.3	434.2	4.0	3.9
243.0	430.0	433.8	433.8	3.8	3.7
242.0	429.8	433.4	433.3	3.6	3.5
241.5	429.7	433.2	433.1	3.5	3.4

May, 19, 2020
INTERPOLATED WATER SURFACE ELEVATIONS

MILE	MP	WS 12:00	WS 16:00	MP DIFF 12:00	MP DIFF 16:00
260.3	434.0	441.8	441.7	7.8	7.6
260.0	433.9	441.7	441.5	7.7	7.6
259.0	433.7	441.3	441.1	7.5	7.4
258.0	433.5	440.8	440.7	7.4	7.2
257.0	433.2	440.4	440.3	7.2	7.0
256.0	433.0	440.0	439.8	7.0	6.8
255.0	432.8	439.6	439.4	6.8	6.6
254.0	432.6	439.1	439.0	6.6	6.4
253.0	432.3	438.7	438.6	6.4	6.2
252.0	432.1	438.3	438.1	6.2	6.0
251.0	431.9	437.9	437.7	6.0	5.8
250.0	431.6	437.4	437.3	5.8	5.7
249.0	431.4	437.0	436.9	5.6	5.5
248.0	431.2	436.6	436.4	5.4	5.3
247.0	431.0	436.2	436.0	5.2	5.1
246.0	430.7	435.8	435.6	5.0	4.9
245.0	430.5	435.3	435.2	4.8	4.7
244.0	430.3	434.9	434.8	4.6	4.5
243.0	430.0	434.5	434.3	4.4	4.3
242.0	429.8	434.1	433.9	4.2	4.1
241.5	429.7	433.9	433.8	4.2	4.1

June 10, 2020
INTERPOLATED WATER SURFACE ELEVATIONS

MILE	MP	WS 900	WS 1700	MP DIFF 900	MP DIFF 1700
265.0	434.0	445.2	445.2	11.2	11.2
264.0	434.0	444.9	444.9	10.9	10.9
263.0	434.0	444.5	444.5	10.5	10.5
262.0	434.0	444.1	444.2	10.1	10.2
261.0	434.0	443.8	443.8	9.8	9.8
260.3	434.0	443.5	443.6	9.5	9.6
260.0	433.9	443.4	443.5	9.4	9.5
259.0	433.7	442.9	443.0	9.2	9.3
258.0	433.5	442.5	442.6	9.0	9.1
242.0	429.8	435.2	435.3	5.4	5.5
241.5	429.7	435.0	435.1	5.3	5.4




DATE	RECORD	MP DIFF	MP DIFF
WATER SURFACE	MP DIFF	1700	1700
ZERO NADVD	400.0	407.0	246.5
MILE	260.3	434.0	425.7
MIN POOL			
	19 MAY 2020	441.8 (1600)	433.9 (1600)
		441.7 (1600)	

Survey Dates: May 19, 2020 May 20, 2020 June 10, 2020	SUBMITTED:	Chief, Engr. Data Mgt. Sect.
Surveyed by: PRAIRIE ENGINEERS	Drawn by: ECD by: PEP	Reviewed by:
APPROVED:	Chief, Geospatial Branch	
U.S. ARMY ENGINEER DIVISION CORPS OF ENGINEERS ST. LOUIS, MISSOURI	UPPER MISSISSIPPI RIVER BASIN MISSISSIPPI RIVER	

240 METERS 800 FEET THE INFORMATION DEPICTED ON THIS MAP REPRESENTS THE RESULTS OF A SURVEY CONDUCTED IN ACCORDANCE WITH THE REQUIREMENTS OF THE MISSISSIPPI RIVER COMMISSION ACT OF 1928.	COMPREHENSIVE SURVEY MILE: 300.0 - 195.0
--	---

PLATE NUMBER 29

This deliverable complies with the Quality Control Plan developed by Prairie Engineers, P.C. and with the procedures and requirements outlined in USACE Engineering Manual ER 1110-1-12.

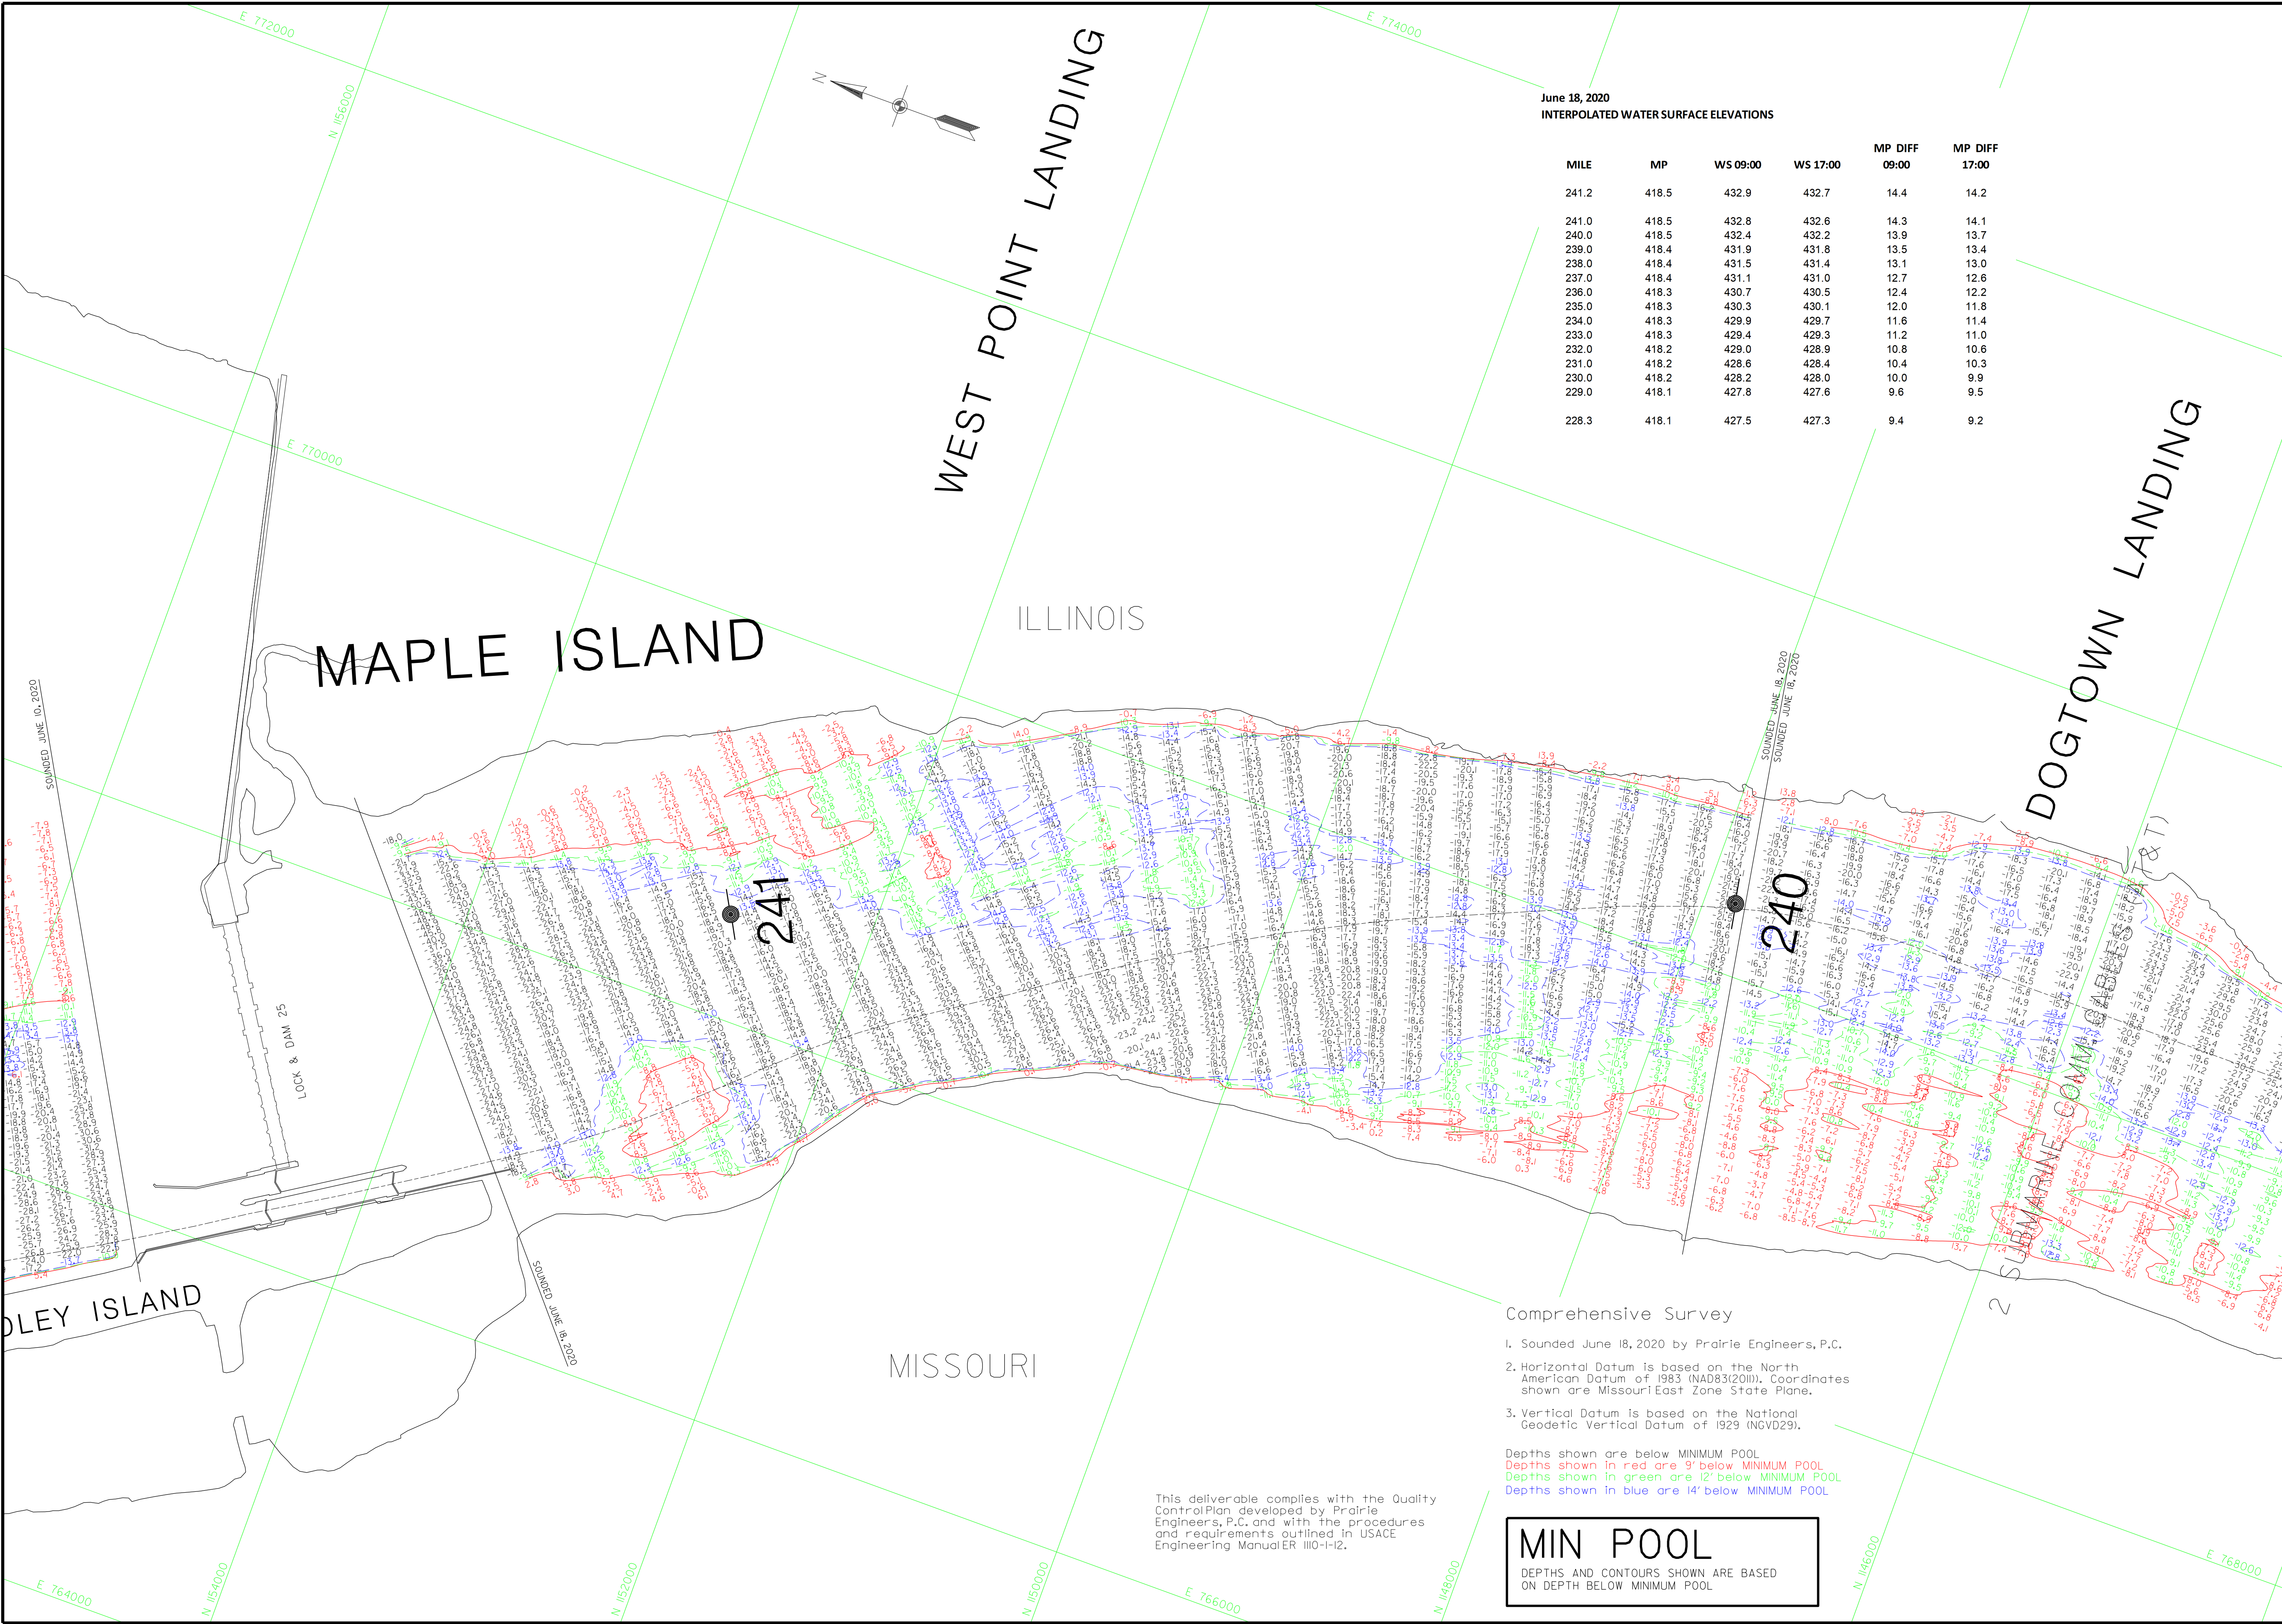

June 18, 2020
INTERPOLATED WATER SURFACE ELEVATIONS

MILE	MP	WS 09:00	WS 17:00	MP DIFF 09:00	MP DIFF 17:00
241.2	418.5	432.9	432.7	14.4	14.2
241.0	418.5	432.8	432.6	14.3	14.1
240.0	418.5	432.4	432.2	13.9	13.7
239.0	418.4	431.9	431.8	13.5	13.4
238.0	418.4	431.5	431.4	13.1	13.0
237.0	418.4	431.1	431.0	12.7	12.6
236.0	418.3	430.7	430.5	12.4	12.2
235.0	418.3	430.3	430.1	12.0	11.8
234.0	418.3	429.9	429.7	11.6	11.4
233.0	418.3	429.4	429.3	11.2	11.0
232.0	418.2	429.0	428.9	10.8	10.6
231.0	418.2	428.6	428.4	10.4	10.3
230.0	418.2	428.2	428.0	10.0	9.9
229.0	418.1	427.8	427.6	9.6	9.5
228.3	418.1	427.5	427.3	9.4	9.2



WATER SURFACE	LAND 25 (L)	DIXON LANDING
407.0	405.5	405.5
241.2	242.3	242.3
418.5	418.5	418.5
432.9 (09:00)	432.9 (09:00)	432.9 (09:00)
432.7 (17:00)	432.7 (17:00)	432.7 (17:00)

Survey Date: June 18, 2020	SUBMITTED:
Drawn by: DCA by: JLM	Chief, Engr. Data Mgt. Sect.
Reviewed by:	File name: 241.200.mxd
APPROVED:	Plot date: 7/31/2020
Chief, Geospatial Branch	Plot scale: 1"=400'

U.S. ARMY ENGINEER DIVISION CORPS OF ENGINEERS ST. LOUIS, MISSOURI	UPPER MISSISSIPPI RIVER BASIN MISSISSIPPI RIVER
--	--

240 METERS 400 800 FEET THE INFORMATION DEPICTED ON THIS MAP REPRESENTS THE RESULTS OF A SURVEY CONDUCTED UNDER THE GENERAL CONDITIONS EXISTING AT THE TIME OF THE SURVEY.	COMPREHENSIVE SURVEY MILE: 300.0 - 195.0
---	---

PLATE NUMBER 30
